


G-4854
42340

T.4N. R.29E. W.M.

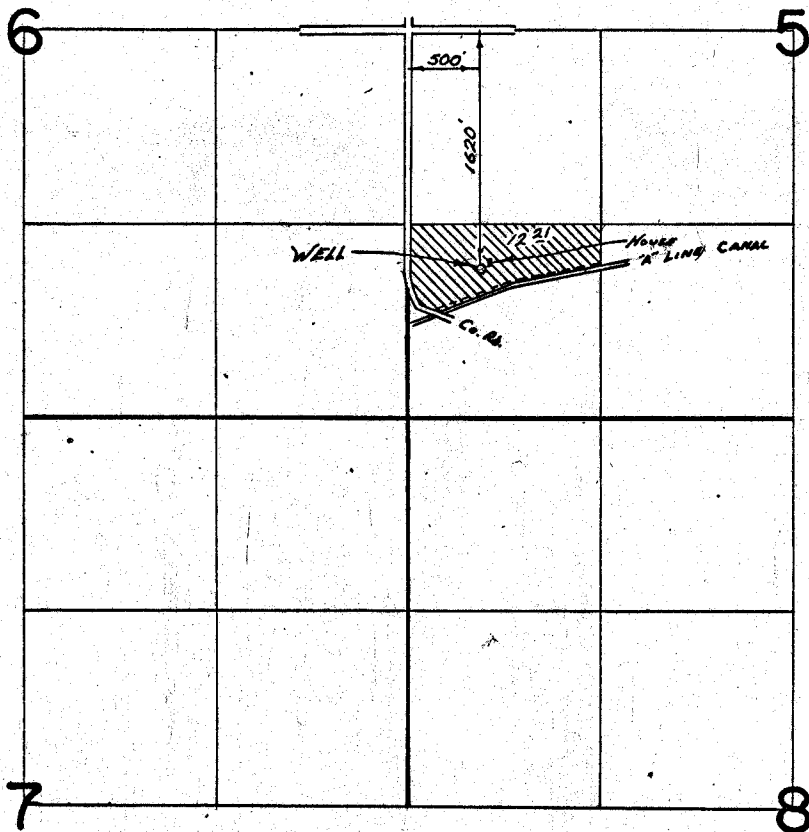

FINAL PROOF SURVEY
UNDER

Application No. G-5115 Permit No. G-4854
IN NAME OF

EARL E. & MAOLA R. BALDWIN

Surveyed APRIL 16 1974, by THOMAS J. PAUL