


G-4964
42341

T.6N. R.34E. W.M.

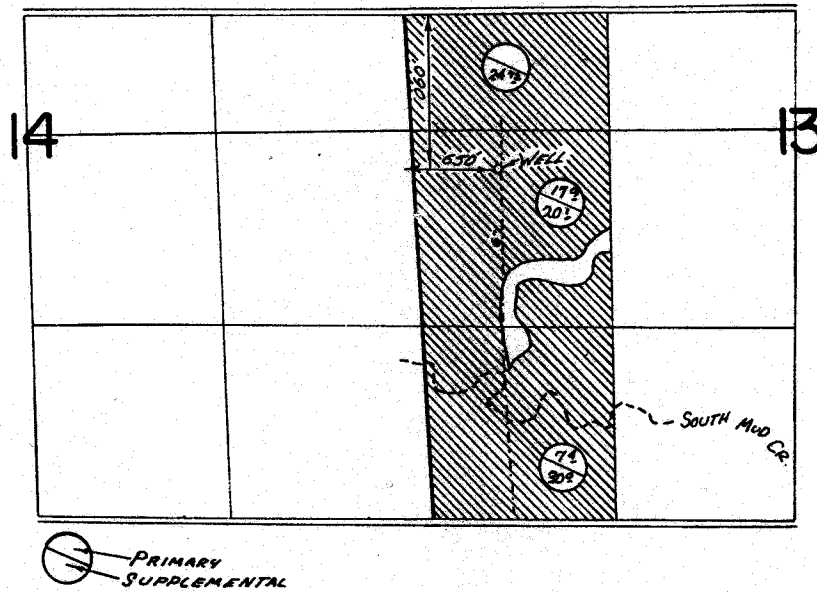

FINAL PROOF SURVEY UNDER

Application No. G-5770 Permit No. G-4964
IN NAME OF

Thomas M. Dixon

Surveyed APRIL 16 1973, by R. G. MUCKEN