


T. 1 S., R. 32 E., W. M.

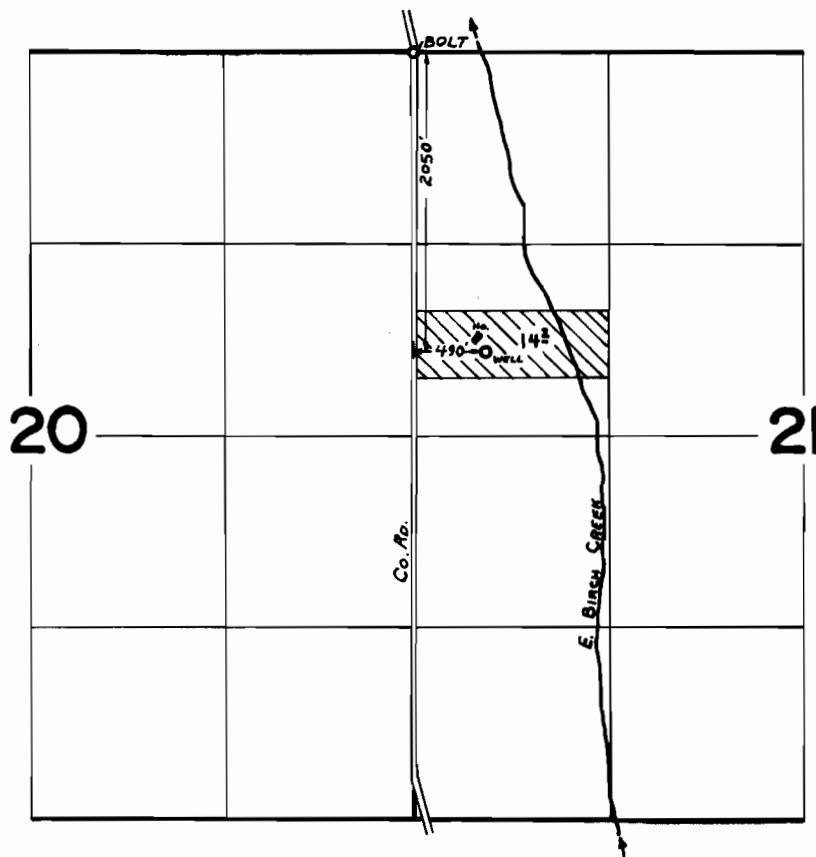

FINAL PROOF SURVEY
UNDER

Application No. G-5759 Permit No. G-5047
IN NAME OF

GEORGE W. JOHNSTON

Surveyed Aug. 7 1974, by L. Toth