


# T.2N.,R.33E.,W.M.

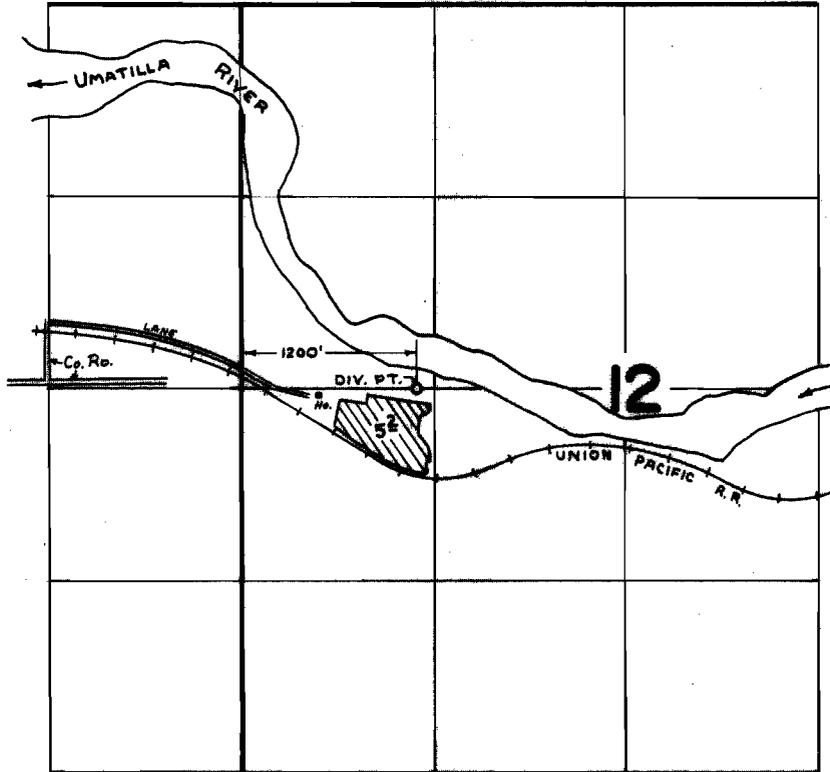

## FINAL PROOF SURVEY UNDER

Application No. 35092.. Permit No. 27481....  
IN NAME OF

WILLIAM J. & PENNY C. ANDREWS

Surveyed Aug. 5 1974, by L. TOLL.....