


T.2S.,R.31E.,W.M.

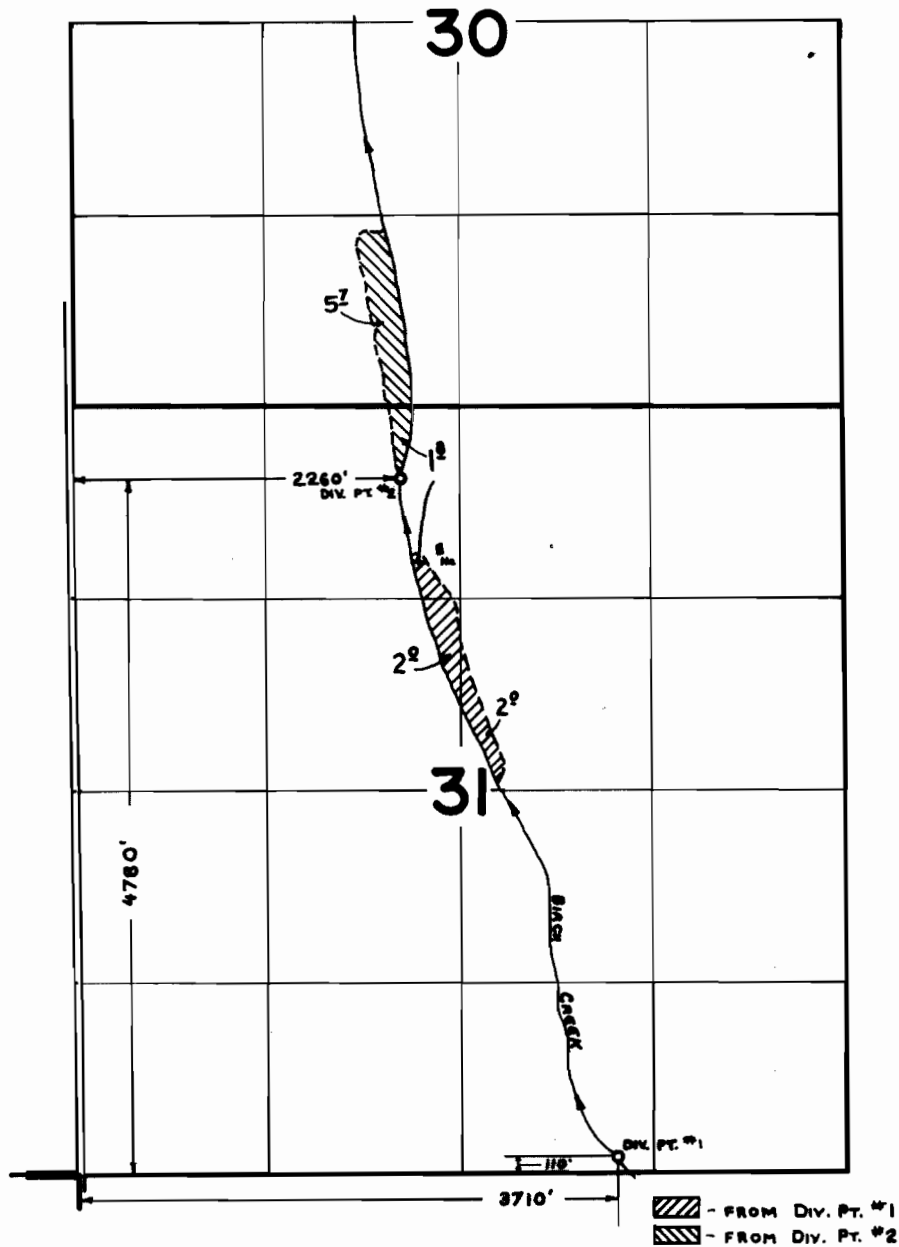

FINAL PROOF SURVEY
UNDER

Application No. 43223 Permit No. 32314
IN NAME OF
DENNIS A. AND MARY A.
HACHLER

Surveyed Aug. 7 1974, by L. TOLL