


T. 1 S., R. 32 E., W.M.

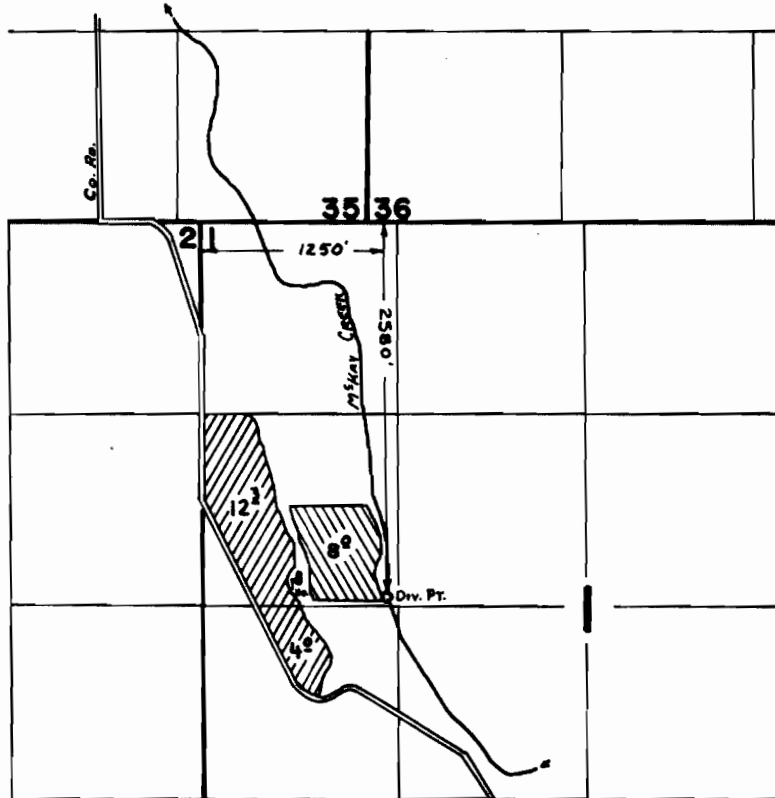

- UNDER Appl. 44362
- UNDER Appl. 46996

FINAL PROOF SURVEY
UNDER

Application No. ~~46996~~ 44362 Permit No. ~~34664~~ 33142
IN NAME OF

.....FRANK RICE.....

Surveyed Aug. 8... 1974, by ...L. TOLL.....