




T.2N.,R.33E.,W.M.

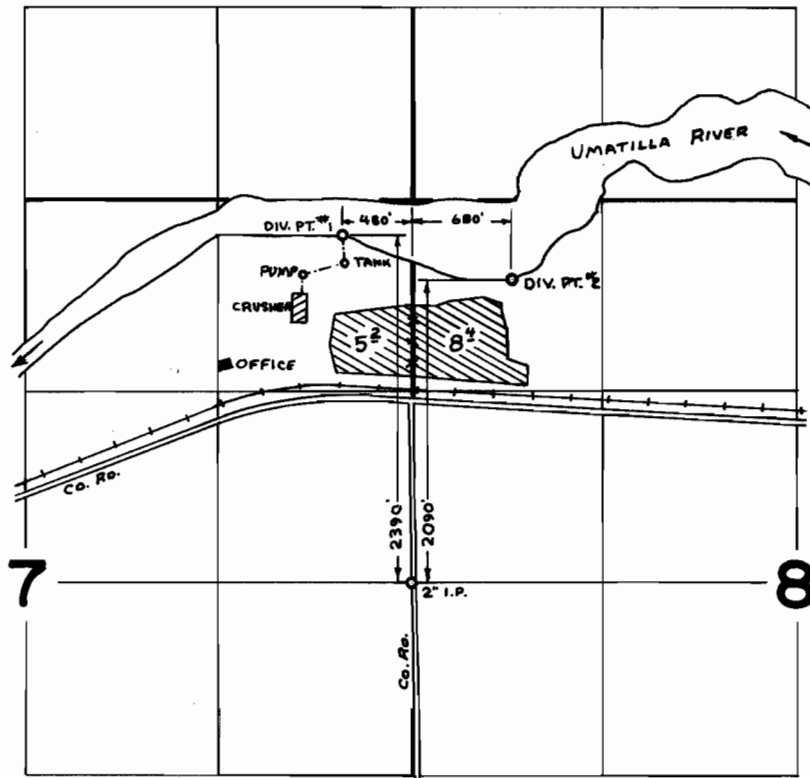

-  - INDUSTRIAL FROM DIV. PT. #1
-  - IRRIGATION FROM DIV. PT. #2

FINAL PROOF SURVEY UNDER

Application No. 44478 Permit No. 33298
IN NAME OF

PENDLETON READY-MIX CO.

Surveyed JULY 31 1974, by L. TOLL