


T.5N., R.29E., W.M.

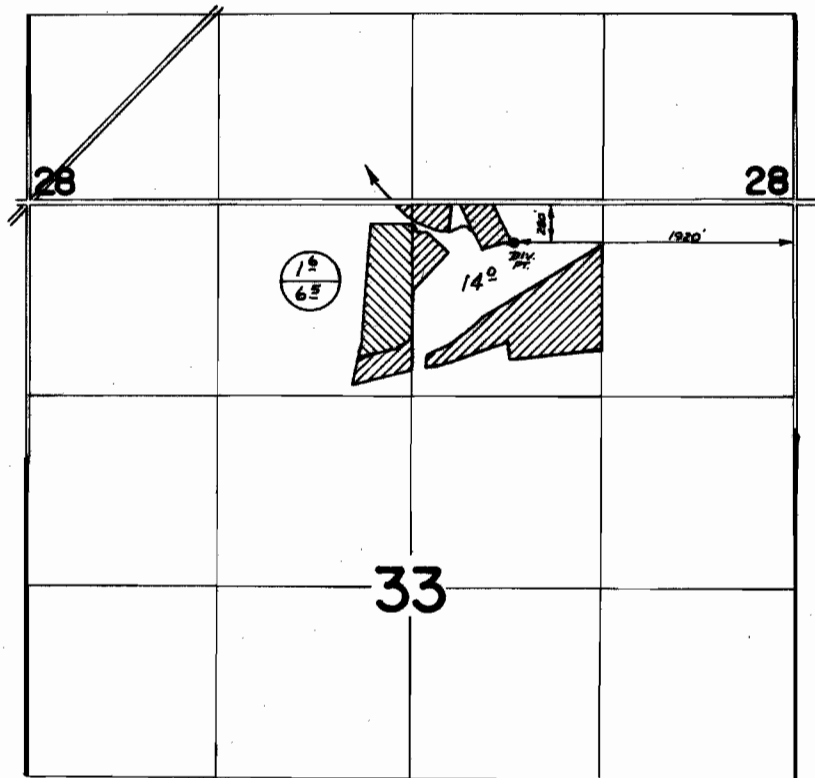

FINAL PROOF SURVEY UNDER

Application No. 44855 Permit No. 33542
IN NAME OF

R. G. BLAHM

Surveyed April 19 1973, by L. E. Gould
April 10, 1974 D. NORBY