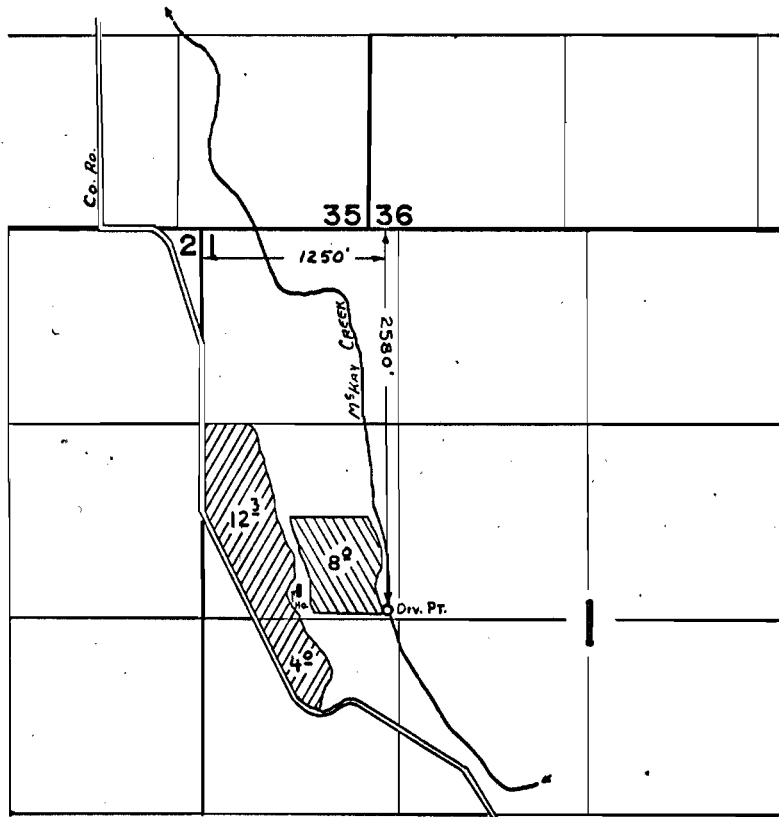

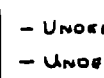


# T. 1 S., R. 32 E., W.M.



-  - UNDER APPL. 44362
-  - UNDER APPL. 46996

## FINAL PROOF SURVEY UNDER

Application No. 44362... 46996... Permit No. 33142... 34664...  
IN NAME OF

FRANK RICE

Surveyed Aug. 8... 1974, by L. TOLL