


T.1S., R.36 & 37 E., W.M.

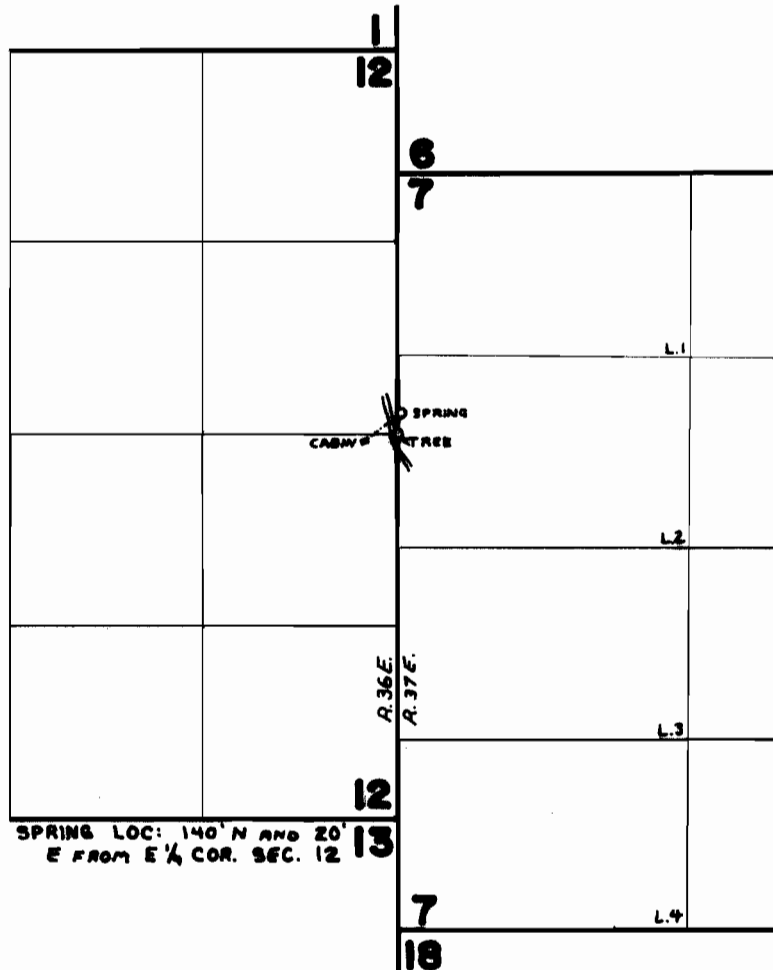

FINAL PROOF SURVEY
UNDER

Application No. ~~46623~~ Permit No. ~~34892~~

IN NAME OF
ROBERT HOSKINS &
FRED HOSKINS, JR.

Surveyed Aug. 2, 1974, by L. T. T. T.