


T.1S.,R.37E.,W.M.

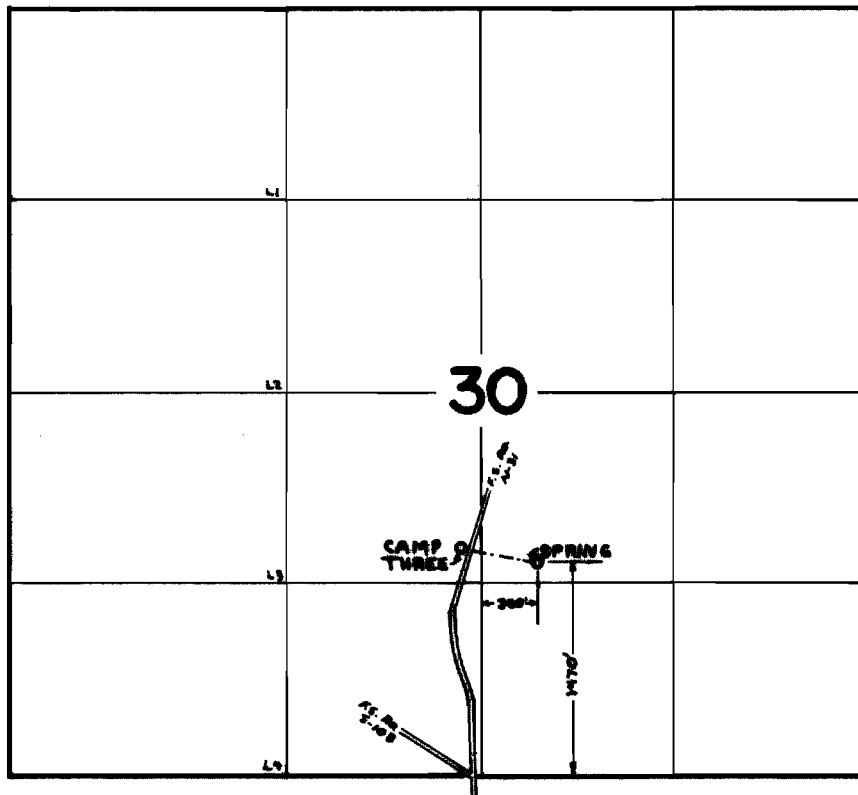

FINAL PROOF SURVEY
UNDER

Application No. 46624 Permit No. 34893
IN NAME OF
ROBERT HOSKINS &
FRED HOSKINS, JR.

Surveyed Ave. 2 1974, by L. TOLL