


# T. 1 N., R. 34 E., W.M.

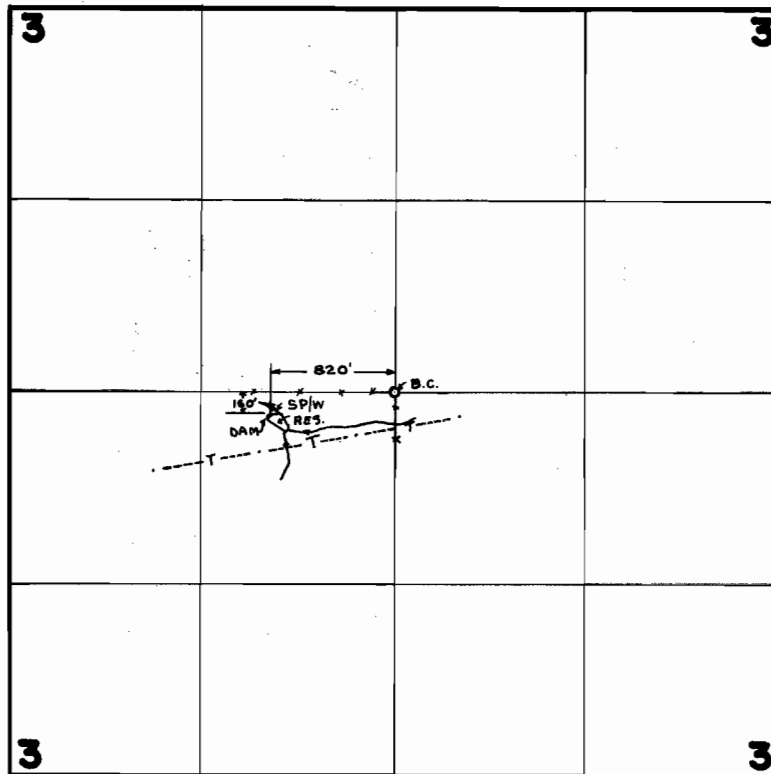

## FINAL PROOF SURVEY UNDER

Application No. ~~R-48385~~ <sup>48156</sup> Permit No. ~~R-5868~~ <sup>36179</sup>  
IN NAME OF

..... LARRY BOLTZ .....

Surveyed JULY 31, 1974, by L. TOLL.....