T.4 S. R.3 W. W.M.

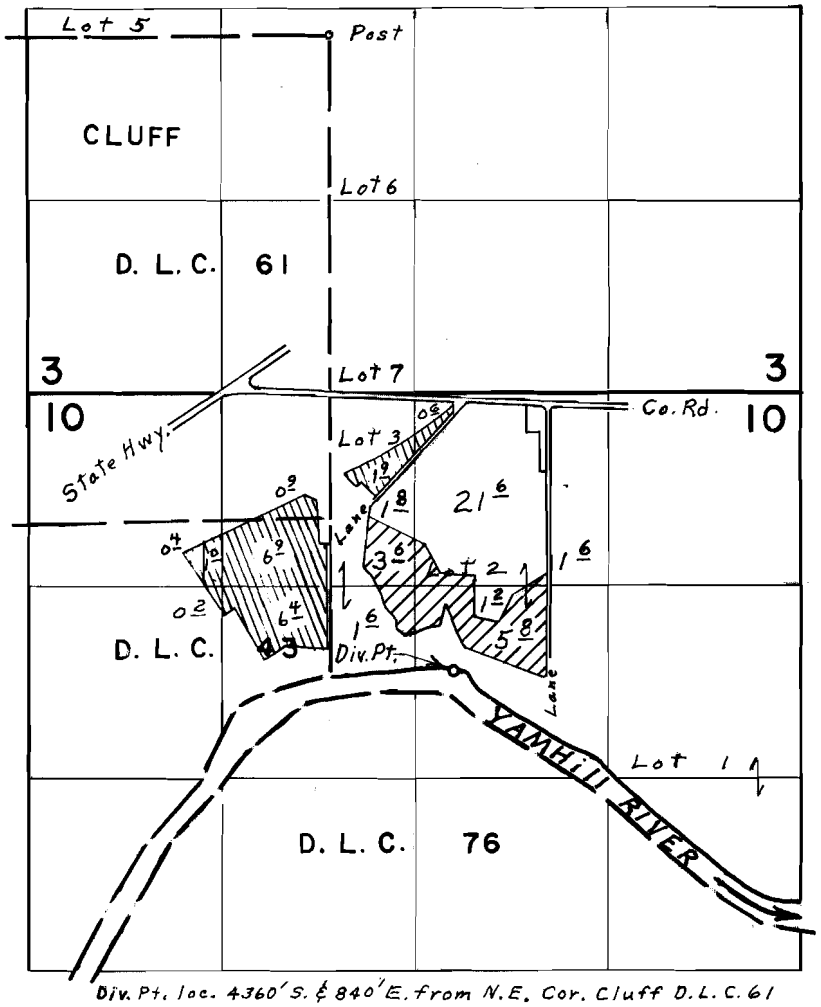

Div. Pt. loc. 4360' S. & 840' E. from N.E. Cor. Cluff D.L.C. 61

FINAL PROOF SURVEY

UNDER

Application No. 44990 50445 Permit No. 33626 38100

IN NAME OF

ROBERT A. PAINE

Surveyed March 15, 1973, by L. E. Gould
May 9, 1979, CR RODRIGUEZ

DFQ-2LL-240