


T.5S. R.3W. W.M.

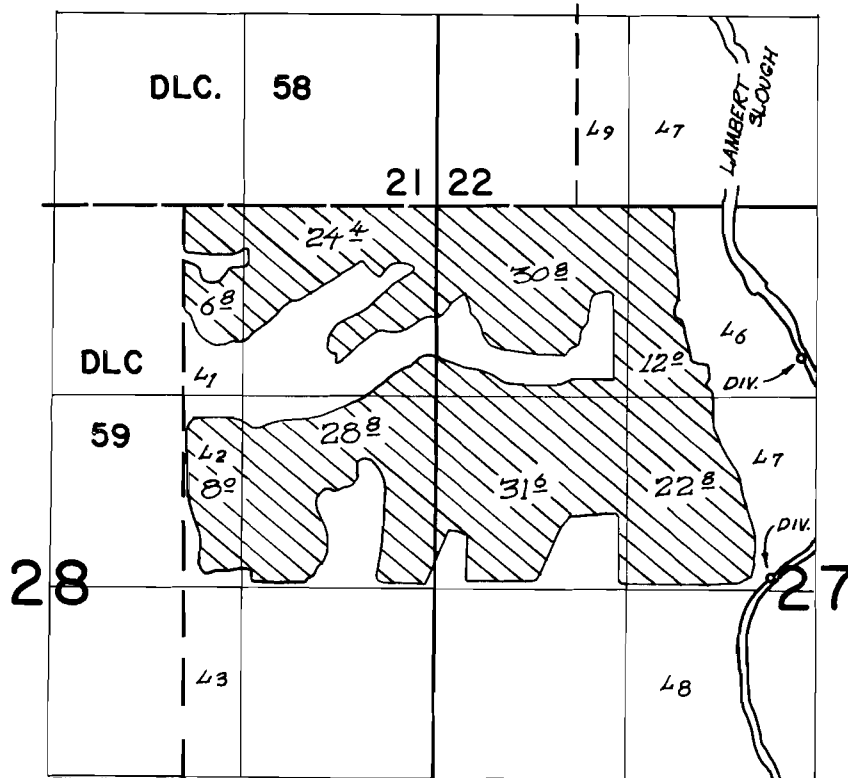

DIV. PTS: - 90°N., 310°W., 1600°N., 100°W.; BOTH FROM CENTER SECTION 27.

FINAL PROOF SURVEY
UNDER

Application No. 45700 Permit No. 34092
IN NAME OF

MICHAEL FARMS INC.

Surveyed MARCH 23 1973, by L. GOULD