


T.3 S. R.5 W. W.M.

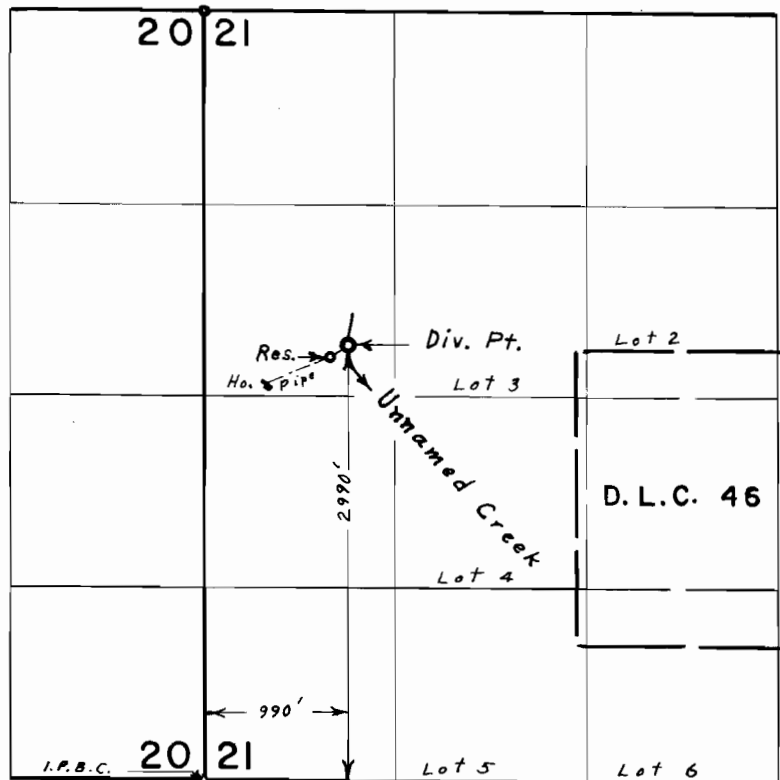

FINAL PROOF SURVEY
UNDER

Application No. 47361 Permit No. 35475
IN NAME OF

JOE AMERSON

Surveyed April 26, 1973, by L. E. Gould