


T. 7S. R. 39E. W.M.

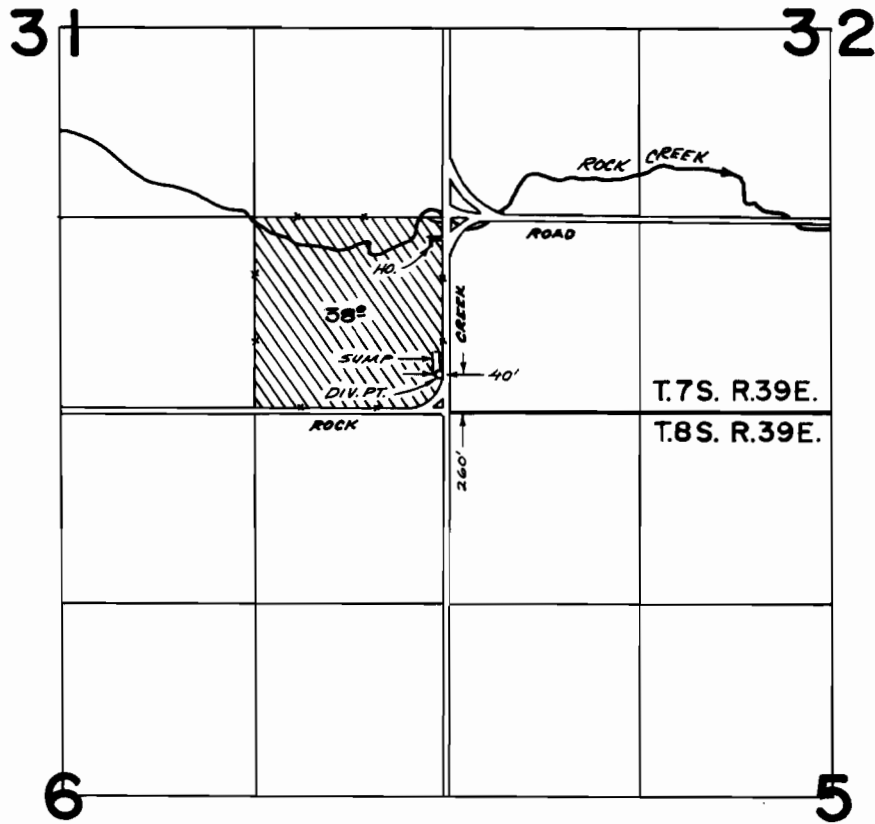

FINAL PROOF SURVEY UNDER

Application No. G. 4633 Permit No. G. 4357
IN NAME OF

Philip D. Stevenson

Surveyed Oct. 24 1974, by L.M.TOLL