


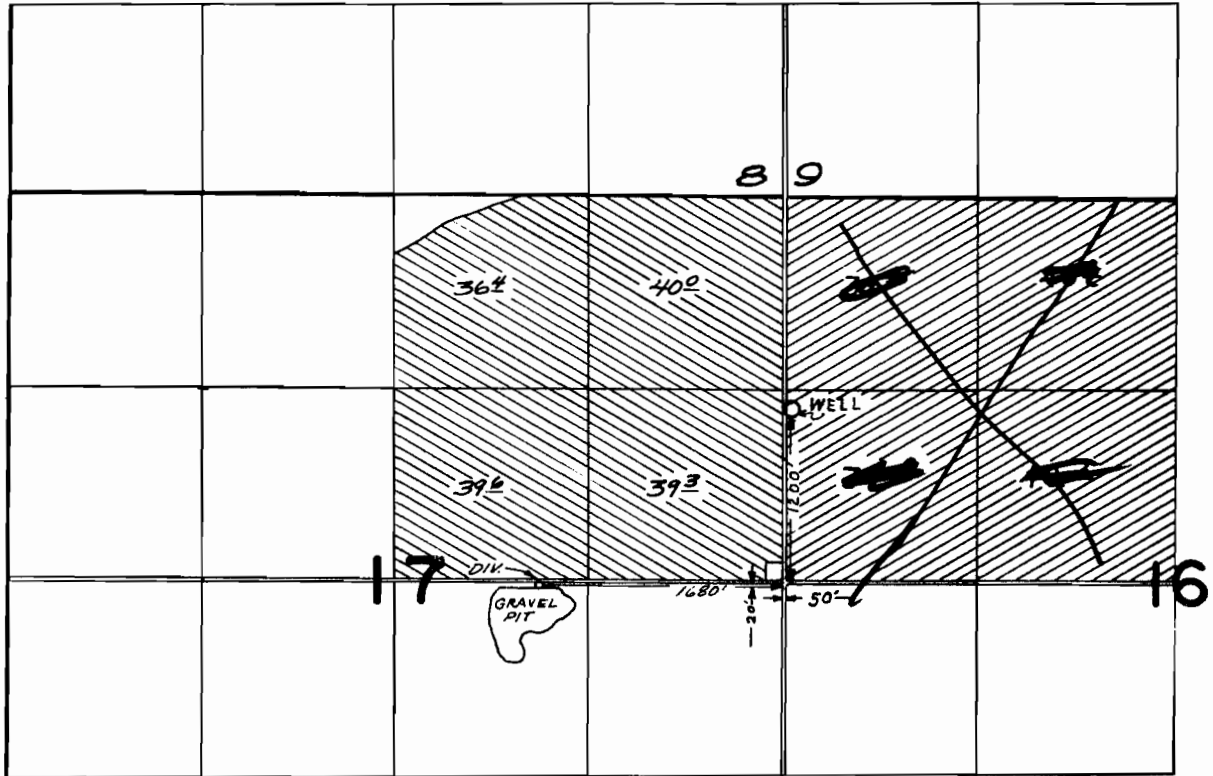

T. 8 S. R. 39 E. W.M.



FINAL PROOF SURVEY UNDER

~~6-8100~~ ~~6-5780~~ 
Application No. 85557 Permit No. 64961 
IN NAME OF

JIM & DAVE BLATCHFORD

Surveyed OCT 30 1974, by L.M. TOLL
JUNE 24 76 C.R. KING

T-10134

BBB 4X4 239 CRK DMS