


T.14 & 15S.R.45E.W.M.

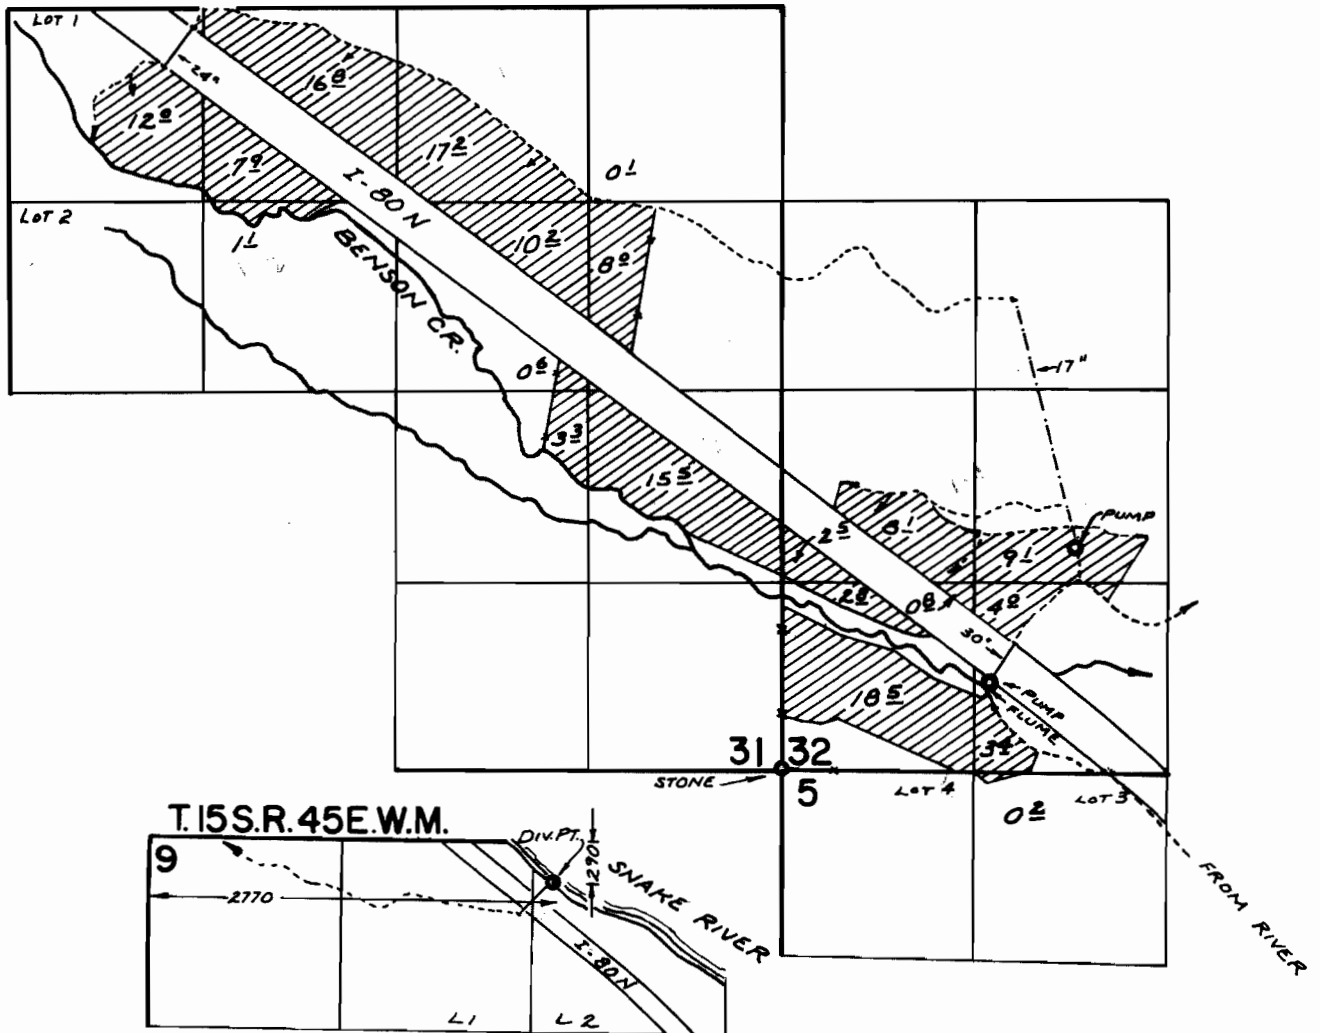

FINAL PROOF SURVEY UNDER

Application No. 40366 Permit No. 30095
IN NAME OF

MRS. EBBA GAY

Surveyed AUG. 8, 1974, by R. MUCKEN