


# T.10S. R.38E. W.M.

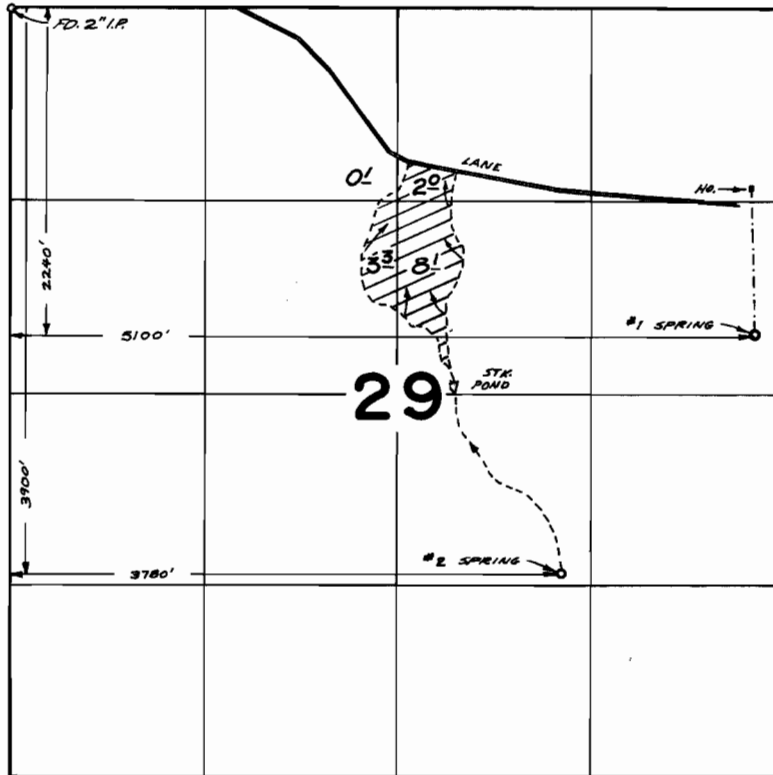

## FINAL PROOF SURVEY UNDER

Application No. 41767 Permit No. 31176  
IN NAME OF

FRED MILLER

Surveyed OCT 29 1974, by L.M. TOLL