


T.13S., R.6W., W.M.

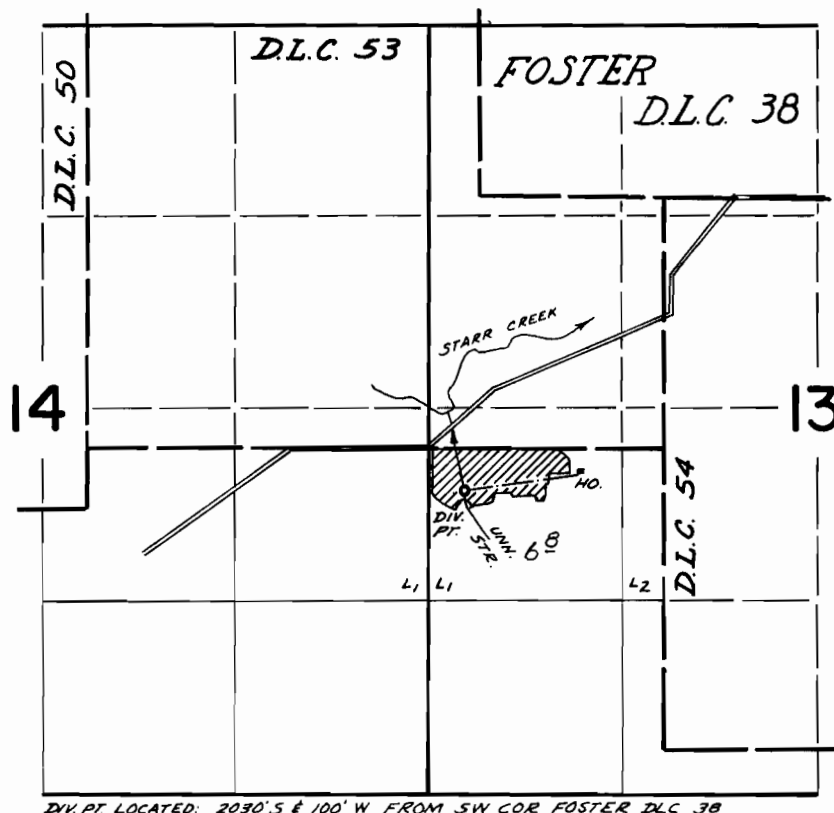

DIV. PT. LOCATED: 2030' S & 100' W FROM SW COR FOSTER DLC 38

FINAL PROOF SURVEY
UNDER

Application No. 41896 Permit No. 31366
IN NAME OF

EVE MUIR

Surveyed APRIL 3 1973, by D. NORBY