


# T.14S., R.5W., W.M.

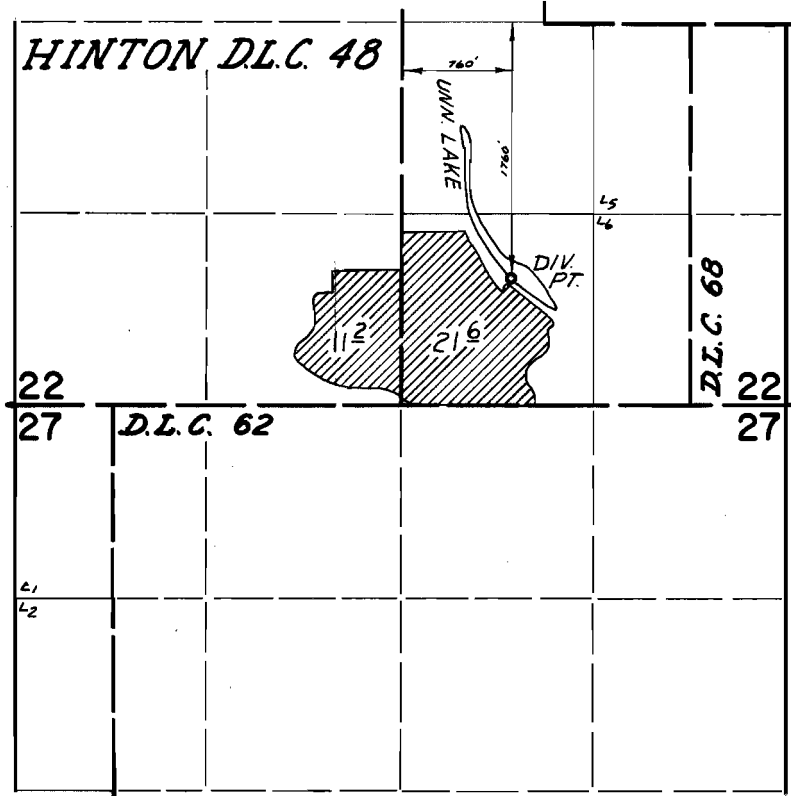

## FINAL PROOF SURVEY UNDER

Application No. 43589 Permit No. 32594  
IN NAME OF

MELVIN BECKER

Surveyed April 5 1973, by D. Norby