


T.4S. R.I.E. W.M.

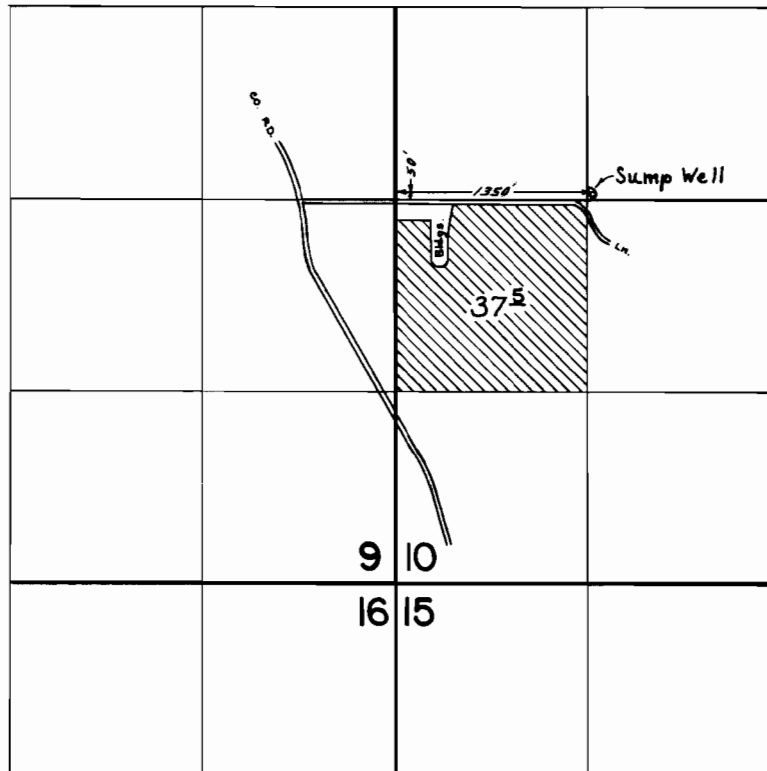

FINAL PROOF SURVEY
UNDER

Application No. G-4748 Permit No. G-4467
IN NAME OF

O. J. KRAXBERGER

Surveyed JULY 17, 1974, by L. E. GOULD