


T. 7 N. R. 4 W. W.M.

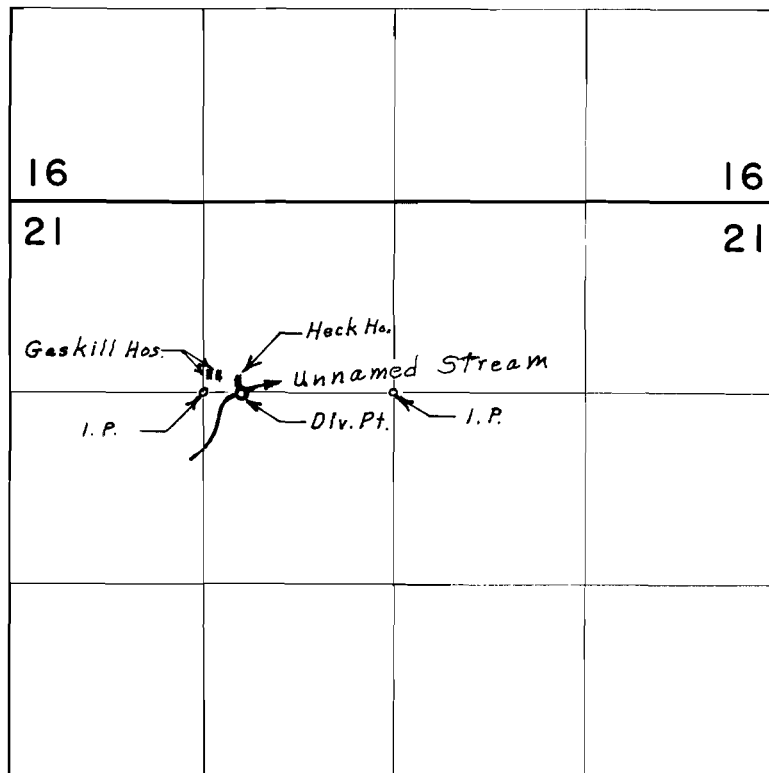

Div. pt. loc.: 10 ft. S. of 250 ft. E. from S.W. Cor. NE 1/4 NW 1/4 Sec. 21

FINAL PROOF SURVEY
UNDER

Application No. 45175 Permit No. 33209
IN NAME OF

Steve Gaskill & Darreld B. Heck

Surveyed July 12, 1973, by L. E. Gould