T.20S.R.22&23E.W.M.

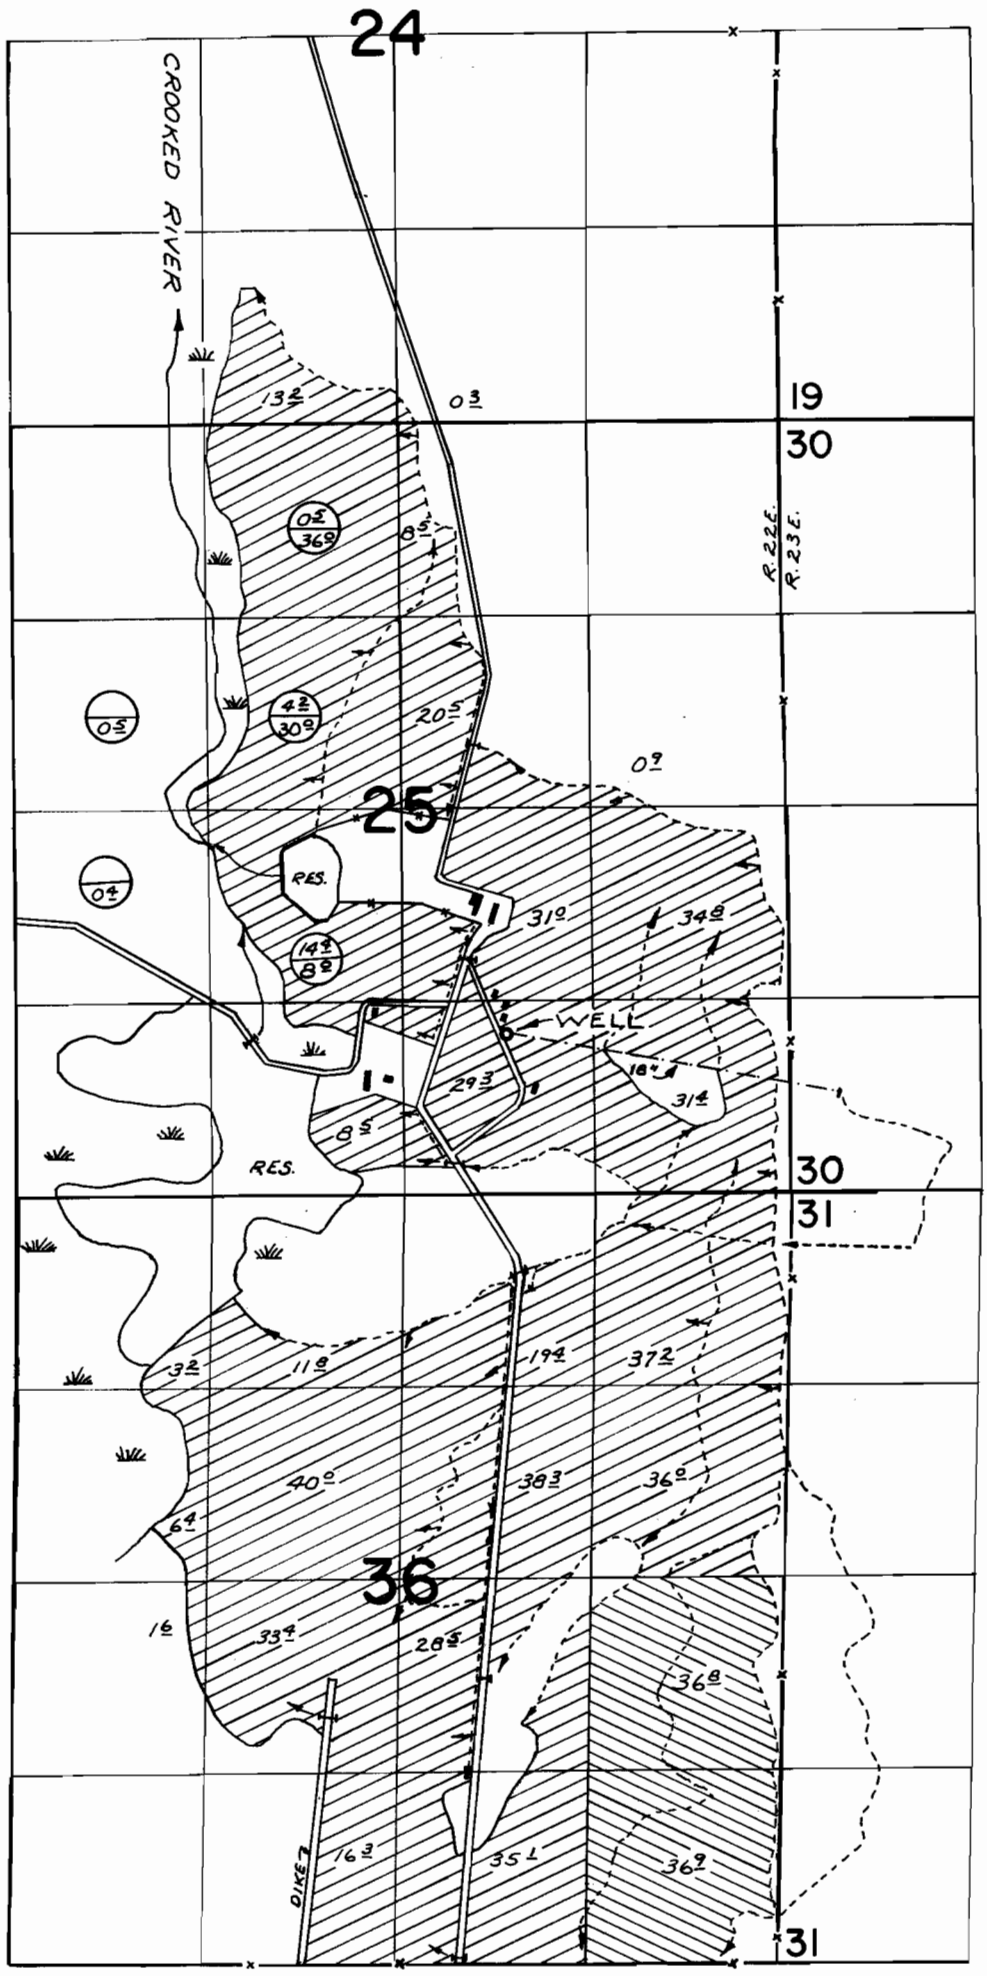

PRIMARY
SUPPLEMENTAL

WELL LOC: 6380'N & 1940'W. FROM S.E. COR. SEC. 31

FINAL PROOF SURVEY

UNDER

Application No. G-5408 G-2608 Permit No. G-5208 G-2422

IN NAME OF

G. I. RANCH

Surveyed JULY 11, 1974, by R. MUCKEN

R.G.M.
DCY-3LL-24 & DCY-3LL-26