


T.31S. R.14&15W. W.M.

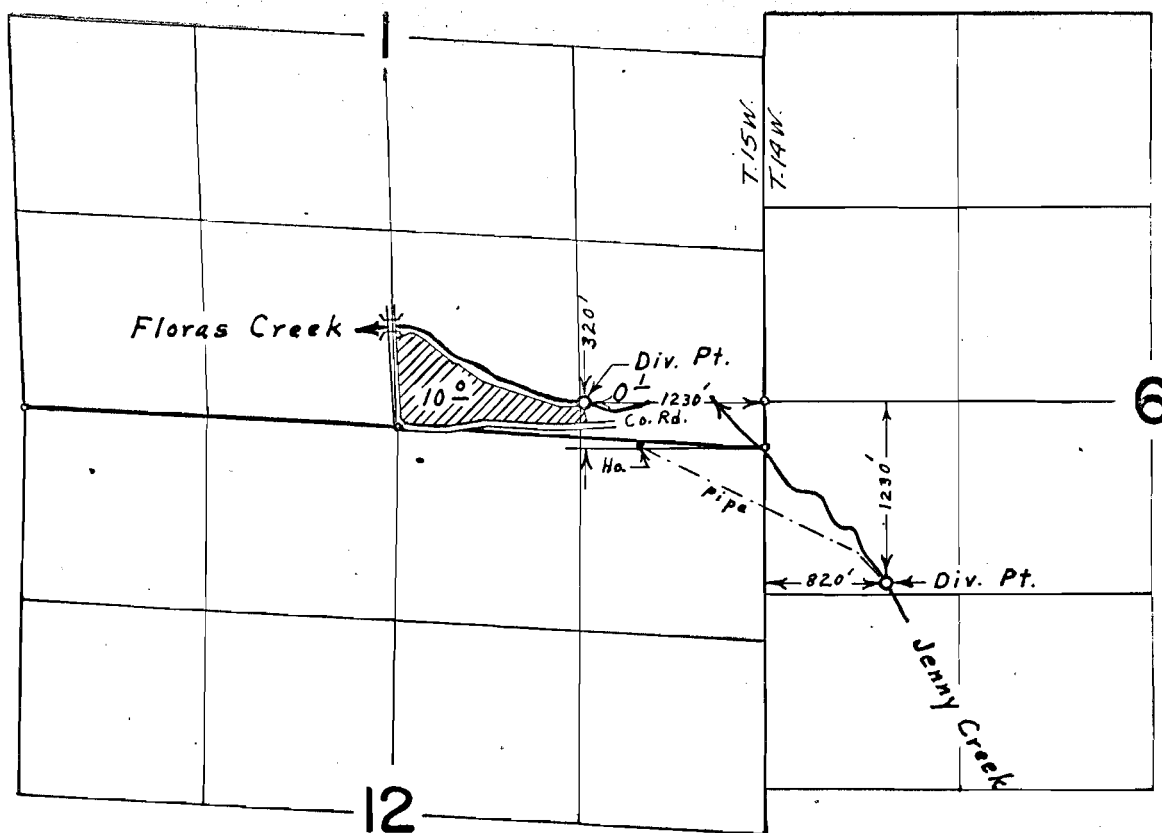

FINAL PROOF SURVEY
UNDER

Application No. 40120 Permit No. 29877
~~40246~~ ~~29853~~
IN NAME OF

VIRGIL A. WOODWARD

Surveyed July 31, 1974
May 15, 1969, by L. E. Gould