


T.32S. R.15W. W.M.

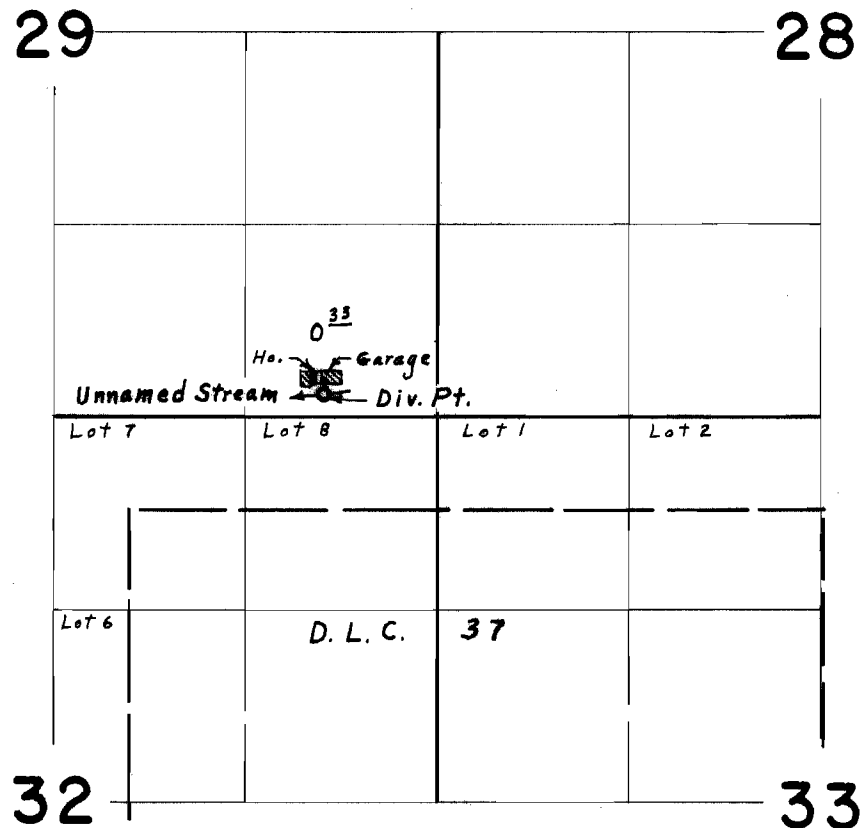

DIV. PT. LOC. - 150 FT. N. & 770 FT. W. FROM SE COR. SEC. 29

FINAL PROOF SURVEY
UNDER

Application No. 43705 Permit No. 32661
IN NAME OF

GERTRUDE E. ADOLPHSEN

Surveyed Aug. 22, 1974, by L. E. Gould