


T.32&33S. R.15W. W.M.

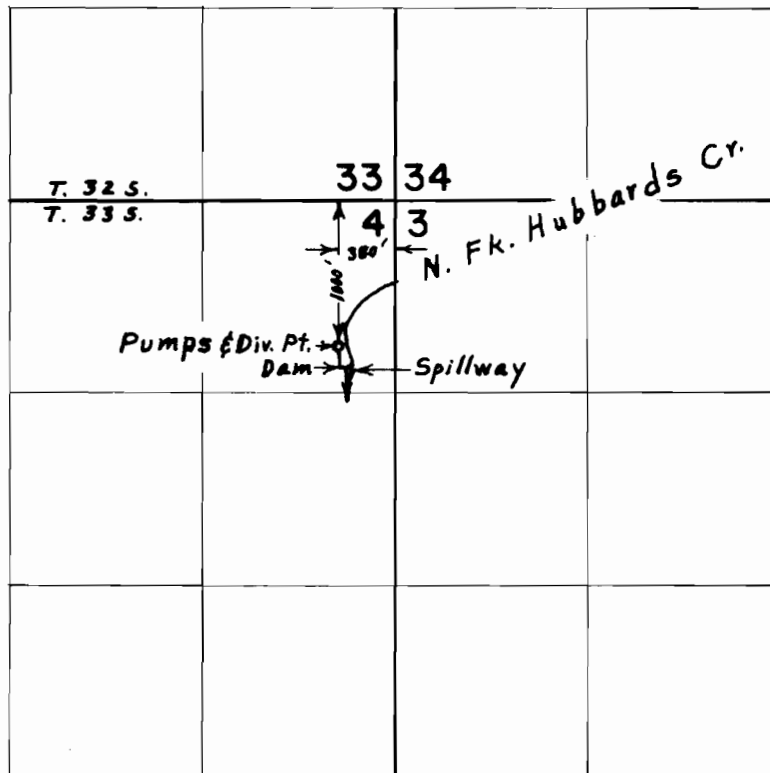

FINAL PROOF SURVEY
UNDER

Application No. 43146 Permit No. 32982
IN NAME OF

CITY OF PORT ORFORD

Surveyed Aug. 21, 1974, by L. E. Gould