


T.31S. R.15W. W.M.

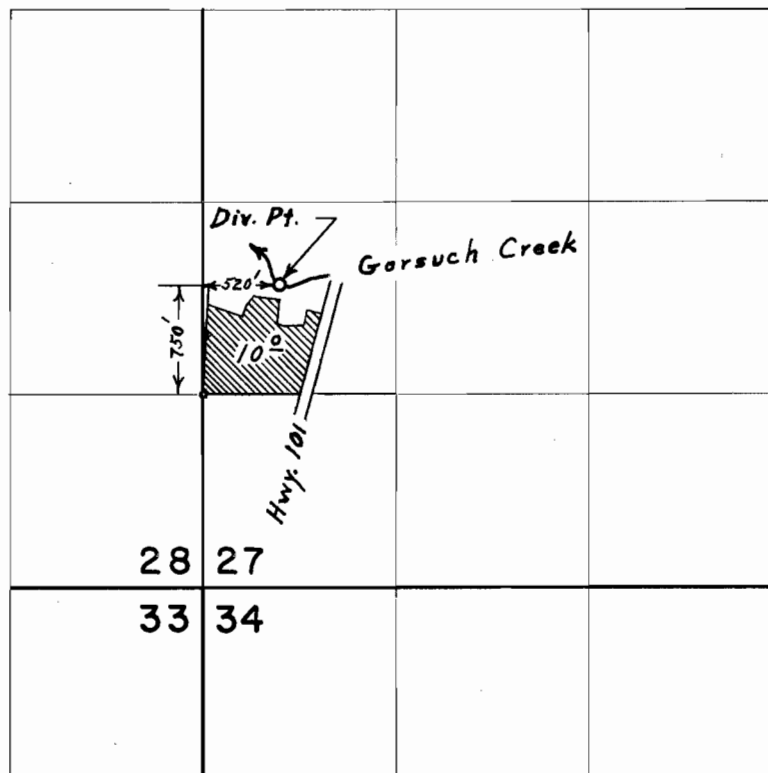

FINAL PROOF SURVEY
UNDER

Application No. 44627 Permit No. 33389

IN NAME OF
TRESSA F. GORSUCH &
ESTATE OF WALTER A. GORSUCH

Surveyed Aug. 1, 1974, by L. E. Gould