


T.35S. R.12W. W.M.

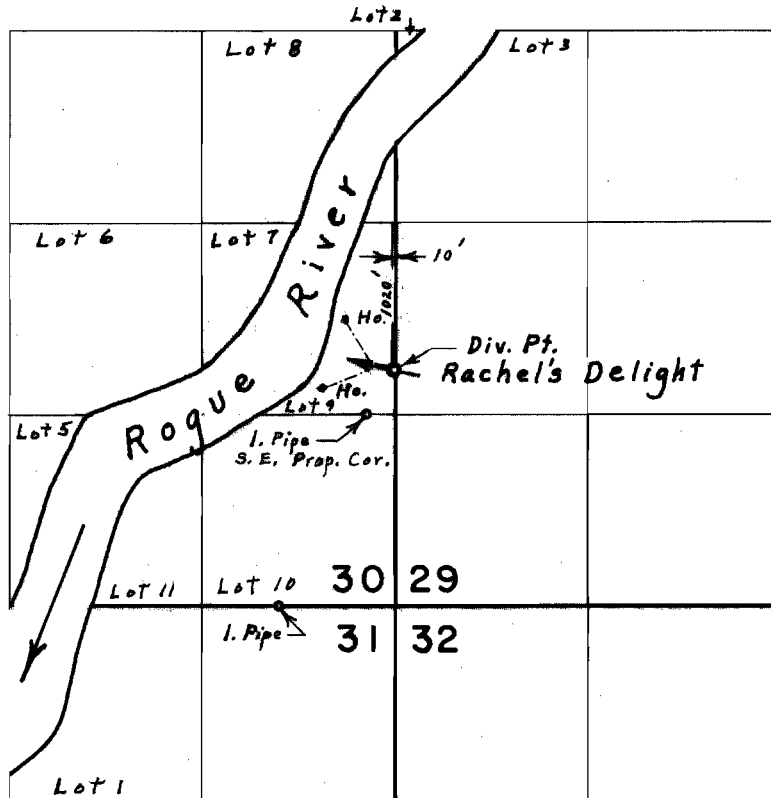

**FINAL PROOF SURVEY**  
UNDER

Application No. 44844 Permit No. 33487  
IN NAME OF

O. W. & MARIAN BETTIS

Surveyed Aug. 26 1974, by L. E. Gould