


T.32&33S. R.14&15W. W.M.

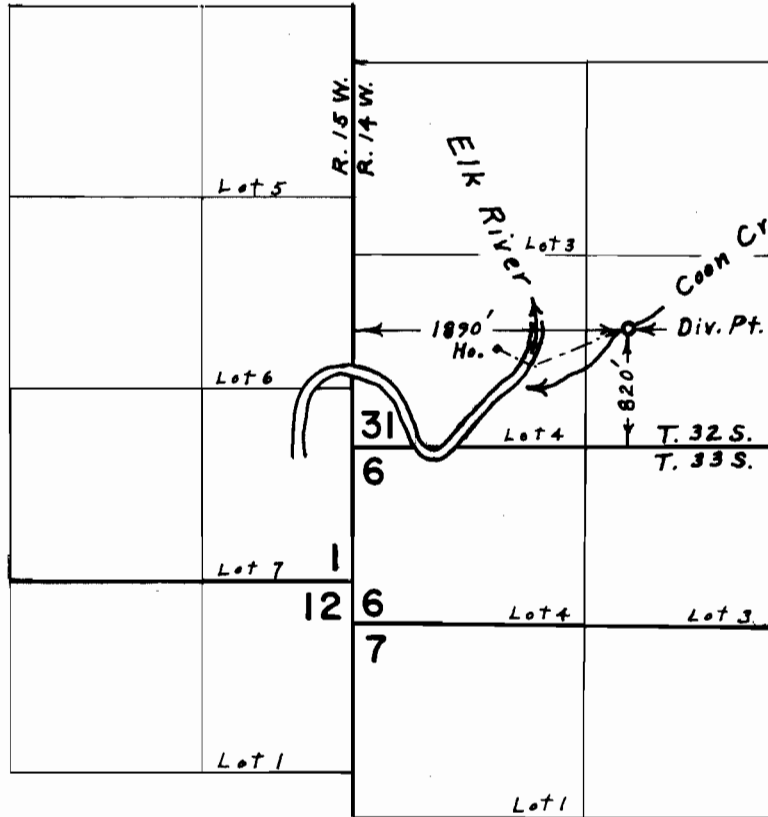

FINAL PROOF SURVEY
UNDER

Application No. 45244 Permit No. 33737
IN NAME OF

MRS. DE WITT BARCLAY

Surveyed Aug. 2, 1974, by L. E. Gould