


# T.32S. R.15W. W.M.

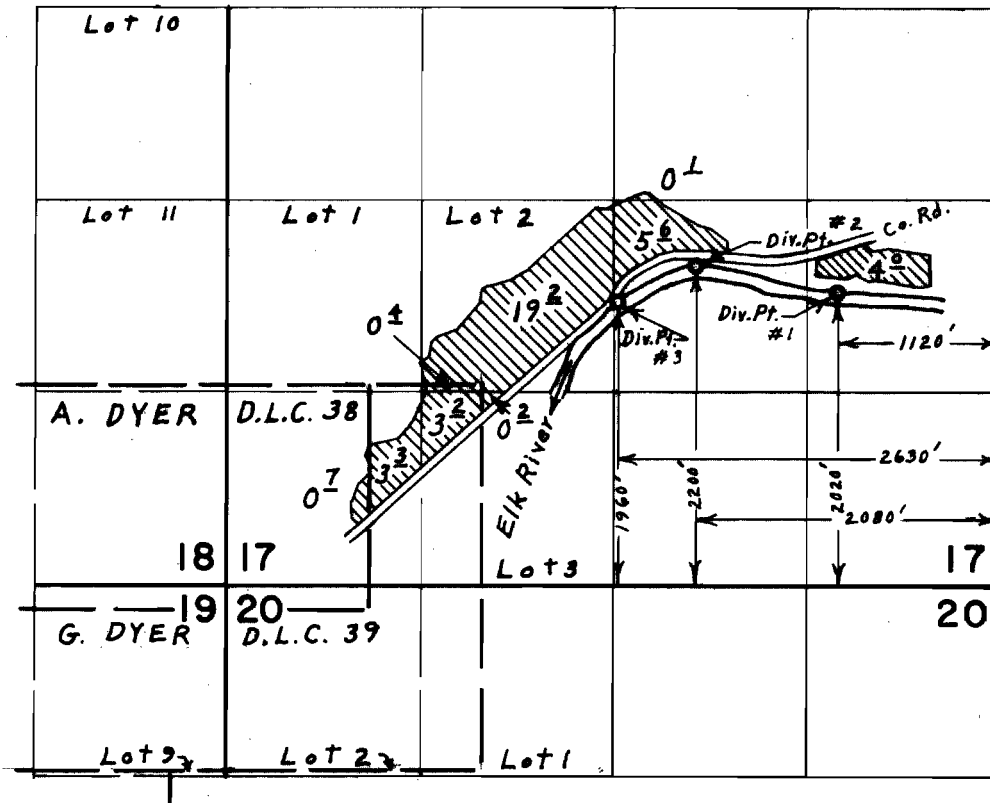

## FINAL PROOF SURVEY UNDER

Application No. 45474 Permit No. 33935  
IN NAME OF

JOHN & GEORGINA WAHL

Surveyed Aug. 8, 1974, by L. E. Gould