


T.32 & 33 S. R.14 & 15 W. W.M.

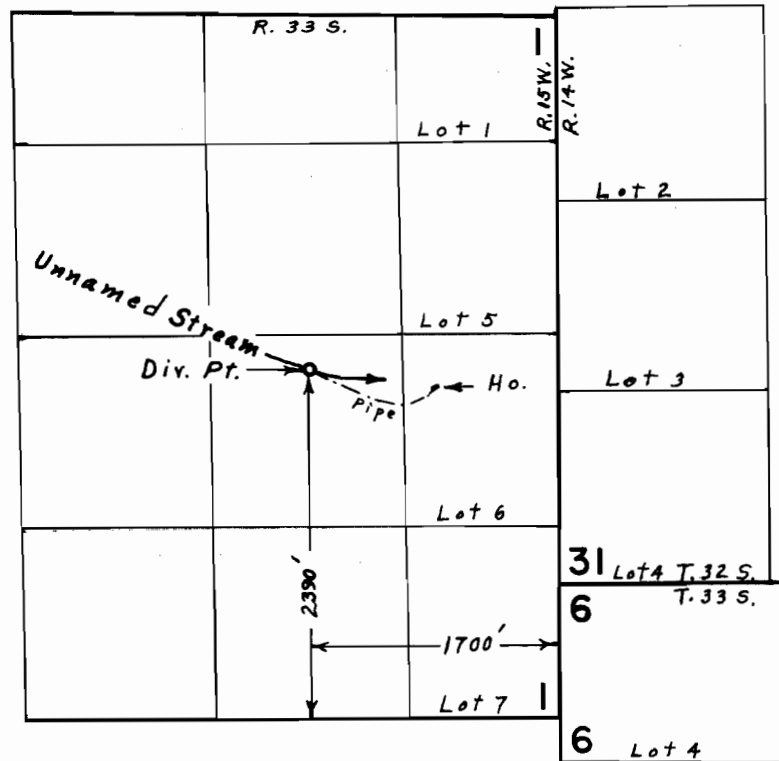

**FINAL PROOF SURVEY**  
UNDER

Application No. 46075 Permit No. 34429  
IN NAME OF

**JOHN BARBER**

Surveyed Aug. 20, 1974, by L. E. Gould