


T.30S. R.15W. W.M.

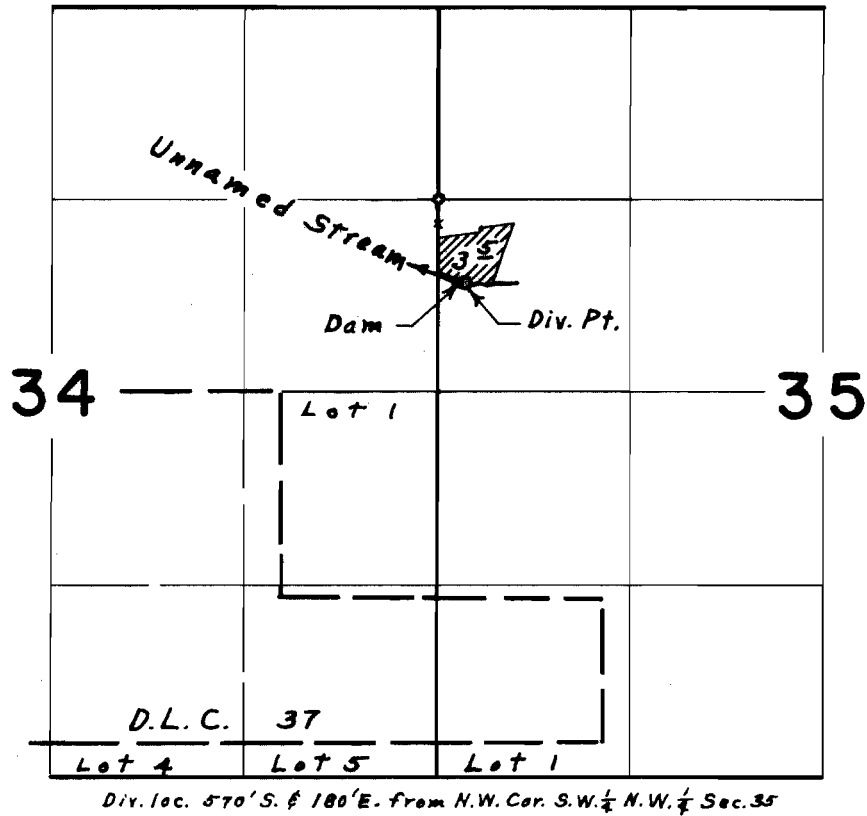

FINAL PROOF SURVEY
UNDER

Application No. 46266 Permit No. 34565
IN NAME OF

ERNEST C. HATMAKER

Surveyed July 30, 1974, by L. E. Gould