


T.37S. R.14W. W.M.

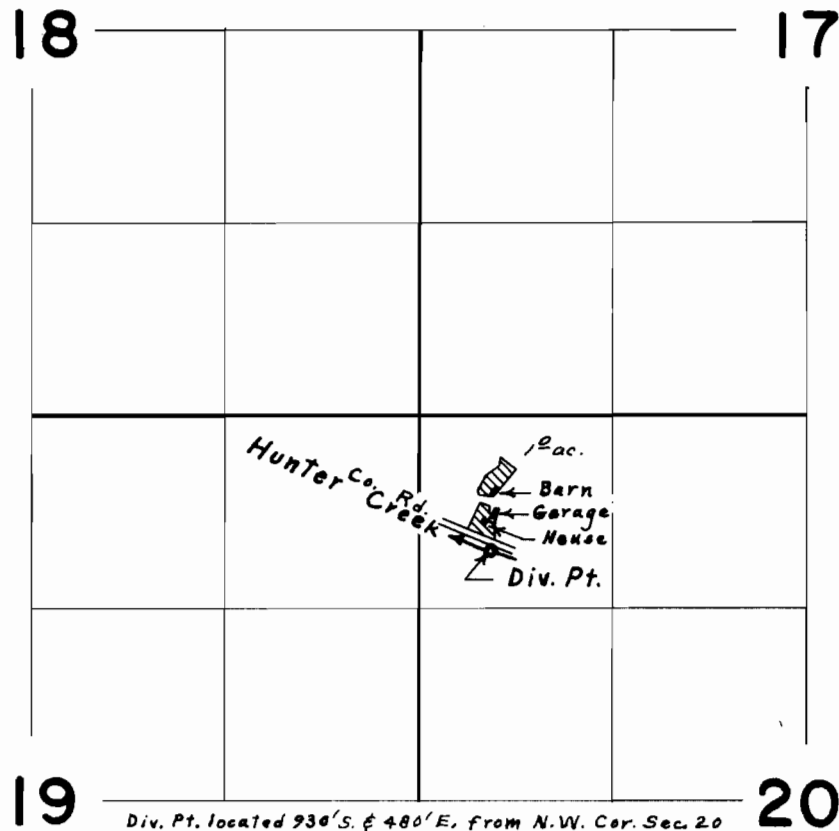

FINAL PROOF SURVEY
UNDER

Application No. 47744 Permit No. 35762
IN NAME OF

ROBERT R. & BETTY L. VANLEER

Surveyed Aug. 22, 1974, by L. E. Gould.