


T.32&33S. R.14&15W. W.M.

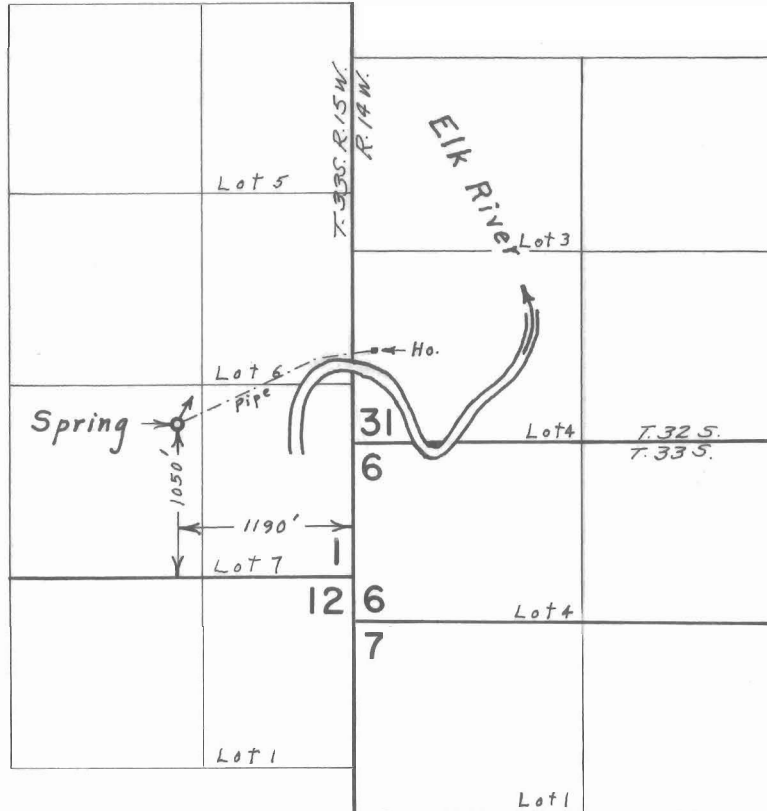

FINAL PROOF SURVEY UNDER

Application No. ~~49576~~... Permit No. ~~37101~~.....
IN NAME OF

MRS. BERNICE A. E. SMITH

Surveyed Aug. 20, 1974, by L. E. Gould.....