


T.37S. R.14W. W.M.

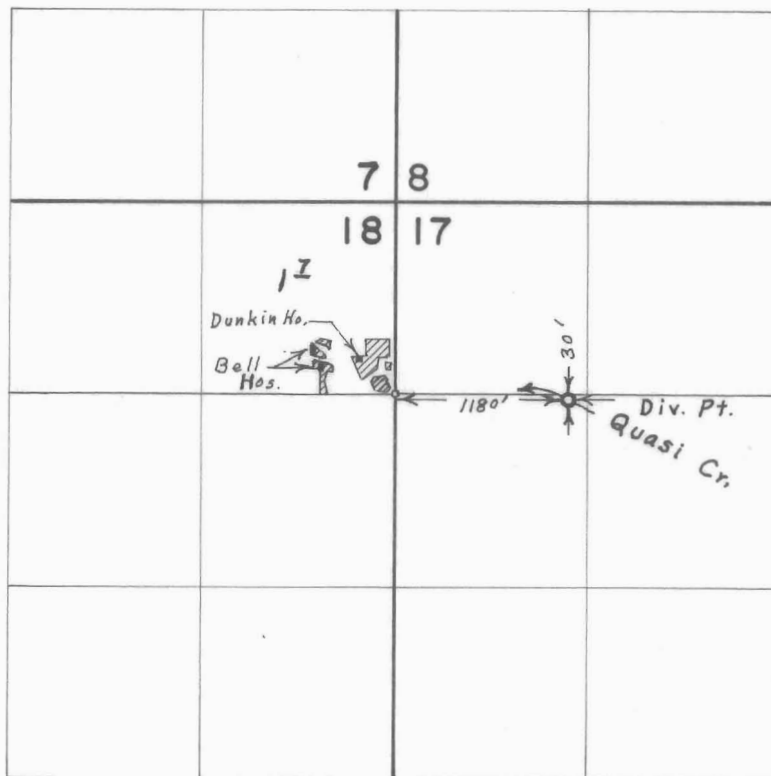

FINAL PROOF SURVEY
UNDER

Application No. 49507. Permit No. 37123
IN NAME OF

LOUIS E. & ZELLA L. DUNKIN

Surveyed Aug. 27 1974, by L. E. Gould