


# T.32&33S. R.14&15S. W.M.

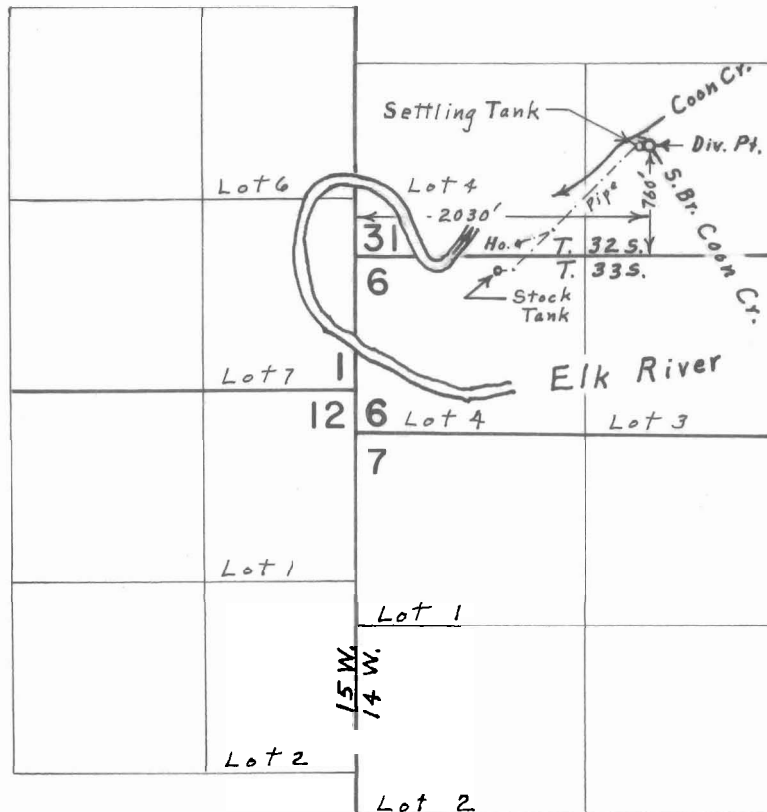

## FINAL PROOF SURVEY UNDER

Application No. 49529 Permit No. 37125  
IN NAME OF

DONALD EDWARD & BILLIE LEE SELL

Surveyed Aug. 9, 1974, by L. E. Gould