


BOARDMAN DEVELOPMENT (), Inc.
TAN, R24E

WEST ENTENICK CANAL

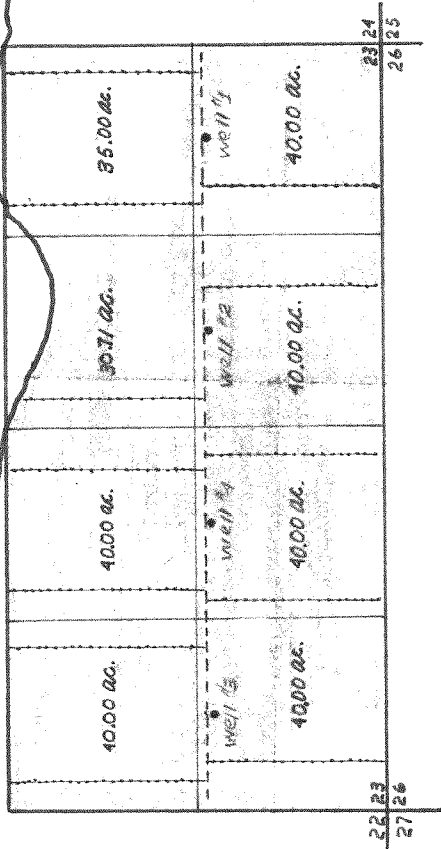

SCALE 8" = 1 MILE

- LEGEND:
- 6" MAIN LINE STEEL PIPE
 - 4" ALUM LATERAL LINES
 - WELL