


T.14 S. R.32 E. W.M.

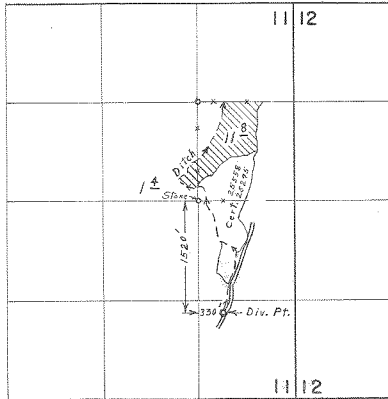

*Final Plat Survey
Under*

Application No. 43572 Permit No. 32584
IN NAME OF (P. 42401)

J. R. CAMPBELL

Surveyed June 11, 1973, by L. E. Gould