


T.13 S. R.32 E. W.M.

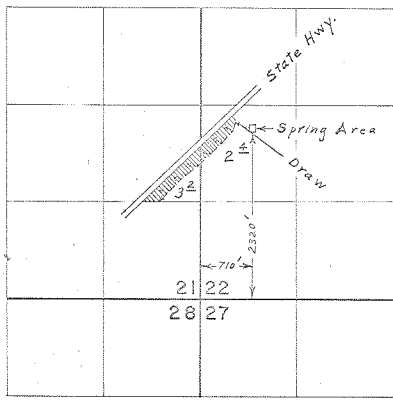

FINAL PROOF SURVEY
UNDER

Application No. 45110. Permit No. 33644.
IN NAME OF *cont 42402*

MILDRED CAMPBELL DEARDORFF

Surveyed June 11, 1974., by L. E. Gould.