


F-36353
42463

T.9 S. R.26 E. W.M.

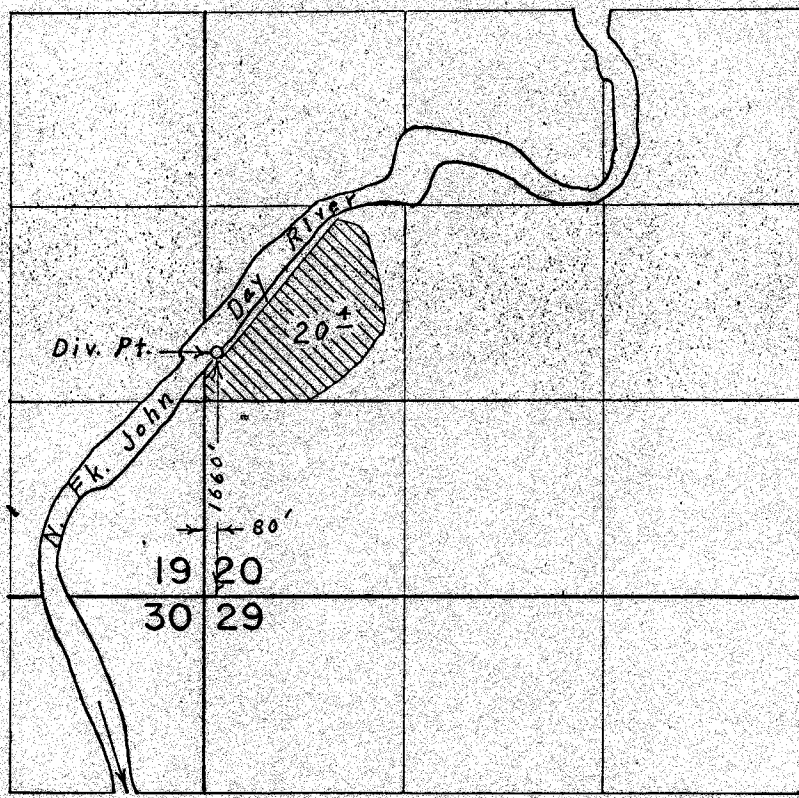

FINAL PROOF SURVEY UNDER

Application No. 48428 Permit No. 36353
IN NAME OF
EVERETT WHEELER

Surveyed June 6, 1974, by L. E. Gould