


T.36S.R.11E.W.M.

Sprague Riv. wells

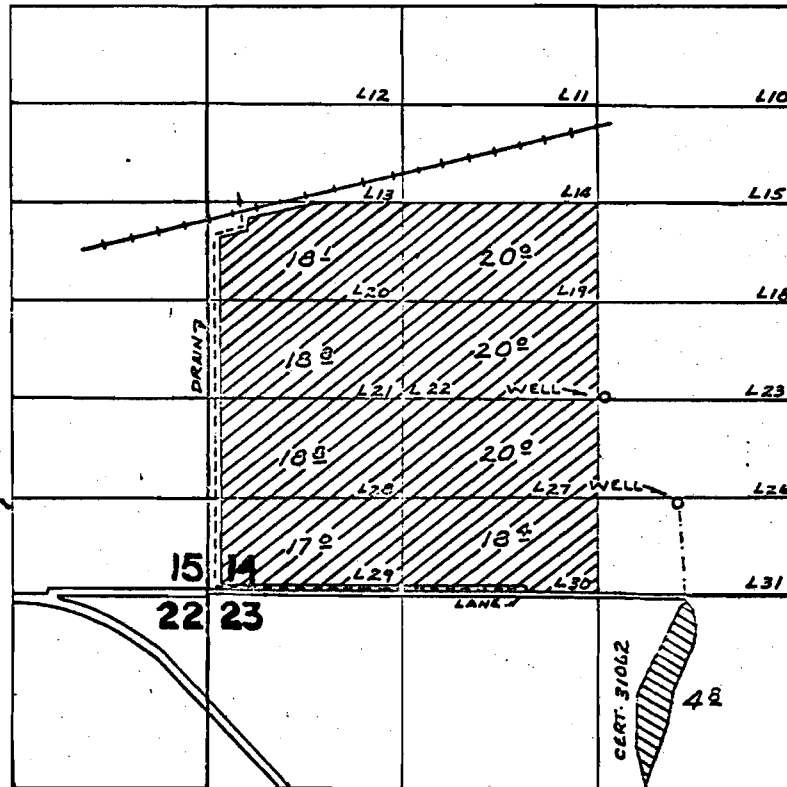

WELLS LOC: 1300'S & 40'E ; 2020'S & 540'E. BOTH FROM
CEN. SEC. 14

FINAL PROOF SURVEY UNDER

Application No. ~~G-4464~~ *G-4599* Permit No. ~~G-4207~~ *G-4605*
IN NAME OF



.....*EDWIN K. & BONNIE K. VIEIRA*.....

Surveyed *OCT. 22, 1974.* by *R. MUGGEN*