


T.36S.R.12E.W.M.

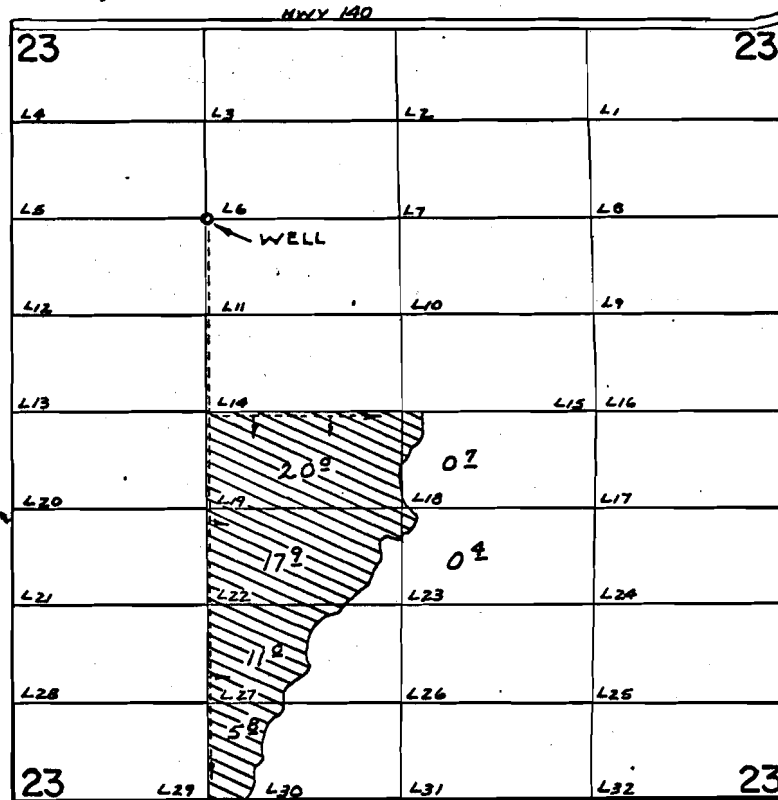

WELL LOC: 11' E. FROM SW. COR. LOT 6 (S $\frac{1}{2}$ NE $\frac{1}{2}$ NW $\frac{1}{4}$) SEC. 23

FINAL PROOF SURVEY

UNDER

Application No. G-4465 Permit No. G-4208
IN NAME OF

EDWIN REZENDES

Surveyed OCT. 23, 1974, by R. MUCKEN