


T.36S.R.11E.W.M.

Sprague Riv. wells

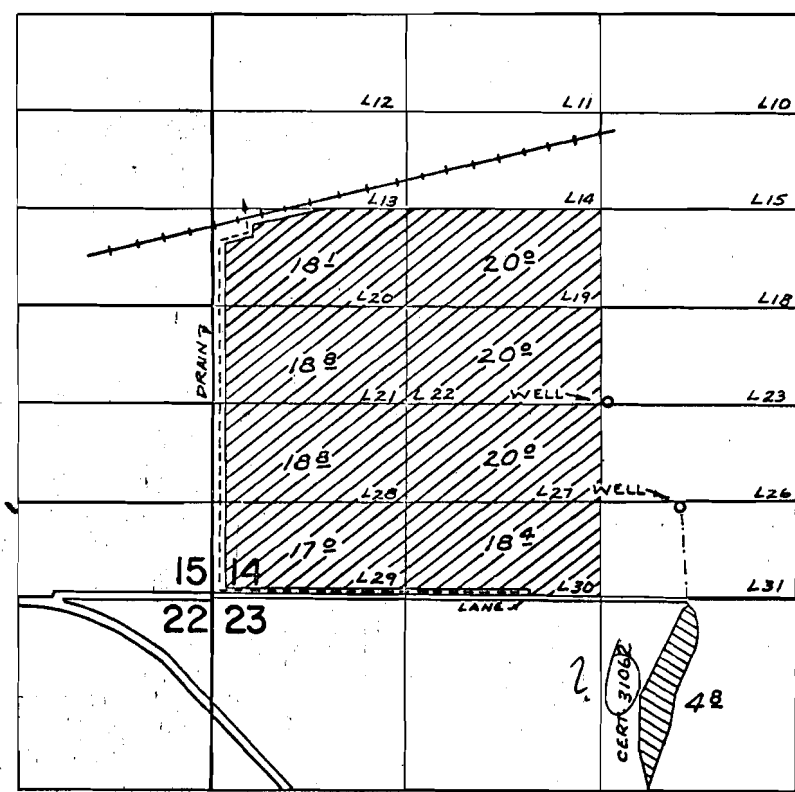

WELLS LOC: 1300'S. & 40'E; 2020'S. & 540'E, BOTH FROM
CEN. SEC. 14

FINAL PROOF SURVEY UNDER

Application No. G-4599 Permit No. G-4207
 Application No. G-4464 Permit No. G-4207
 IN NAME OF



.....EDWIN K. & BONNIE K. VIEIRA.....

Surveyed OCT. 22, 1974, by R. MUGKEN