


G-4692

42407

T.36S.R.11E.W.M.

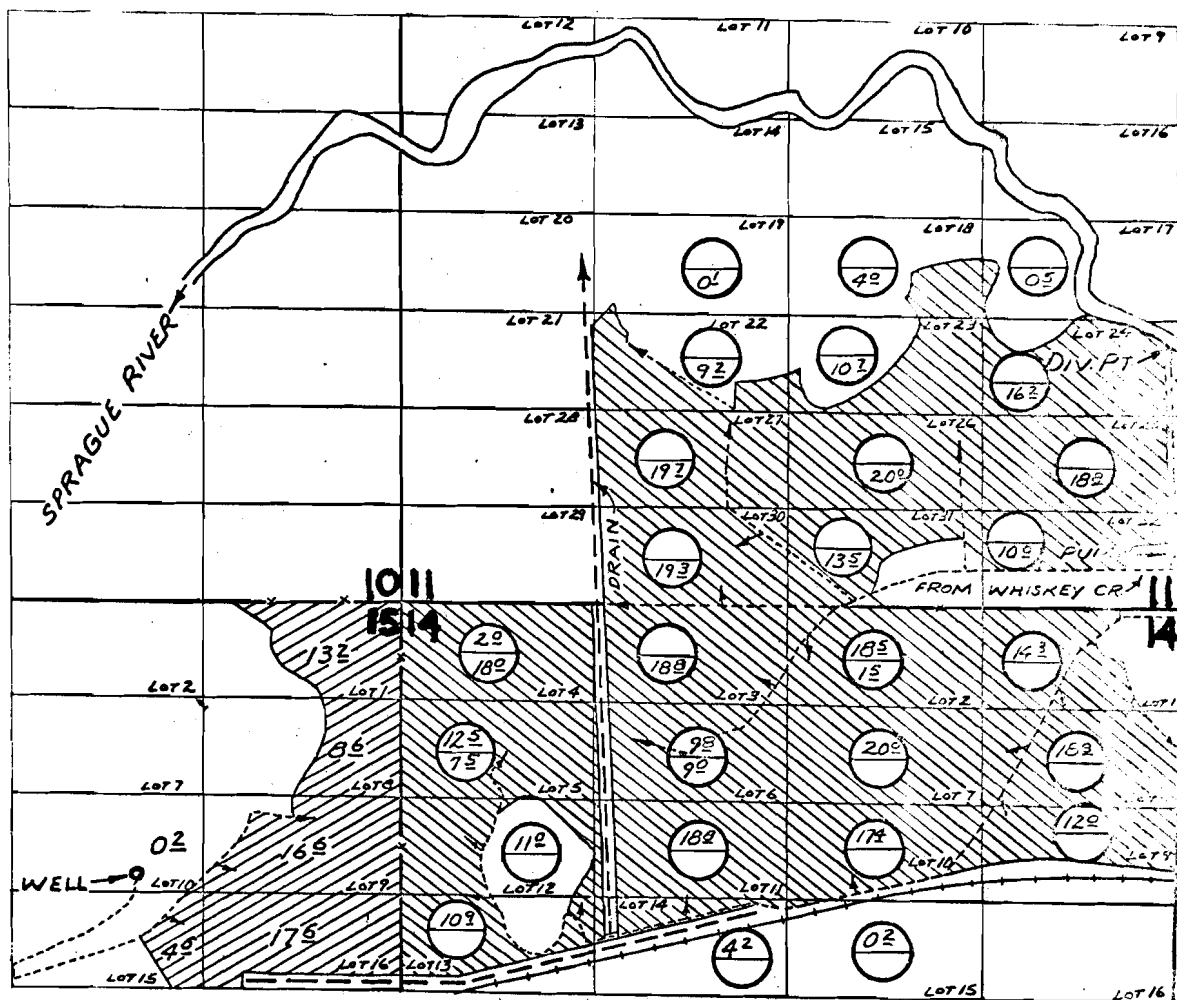

WELL LOC: 1850'S. & 1800'W. FROM N.E. COR. SEC. 15
 DIV. PT. LOC: 1780'N. & 60'W. FROM S.E. COR. SEC. 11

○ → PRIMARY
 → SUPPLEMENTAL } PERMIT 34636

FINAL PROOF SURVEY UNDER

Application No. G-4976 Permit No. G-4692
46369 34636
 IN NAME OF

DENIS HICKEY

Surveyed OCT. 31 1974, by R. MUCKEN

Sprague River wells