34636

42409

T.36S.R.11E.W.M.

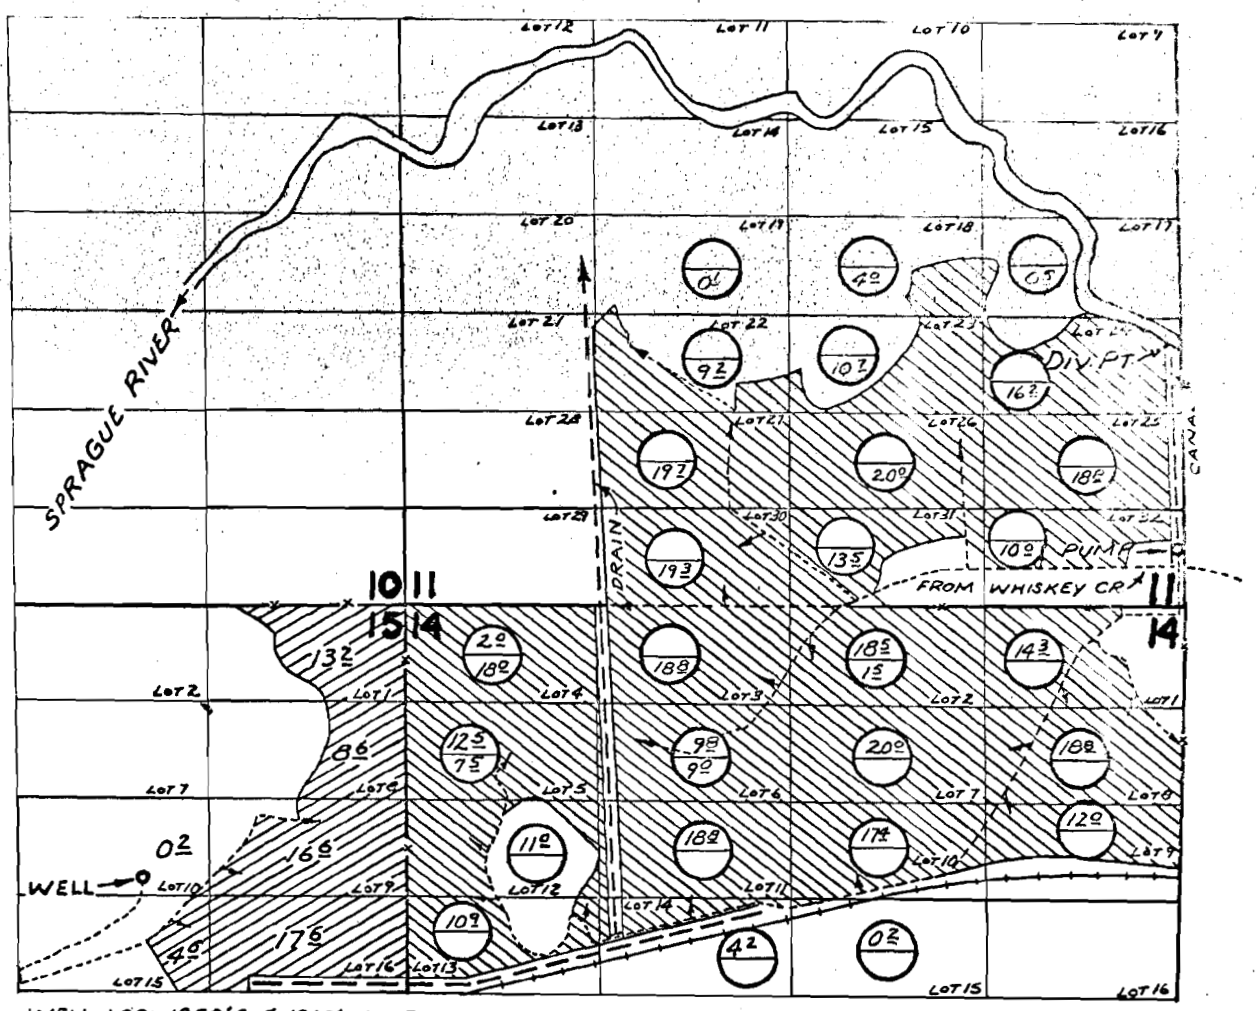

WELL LOC: 1850'S. & 1800'W. FROM N.E. COR. SEC. 15
DIV. PT. LOC: 1780'N. & 60'W. FROM S.E. COR. SEC. 11
PRIMARY
SUPPLEMENTAL } PERMIT 34636

Sprague River

FINAL PROOF SURVEY
UNDER

Application No. ~~46369~~ G-4976 Permit No. ~~34636~~ G-4692
IN NAME OF

DENIS MICKEY

Surveyed Oct. 31 1974, by R. MUCKEN

1974-I &
CNO-3JN-203