


T.18S.R.2W.W.M.

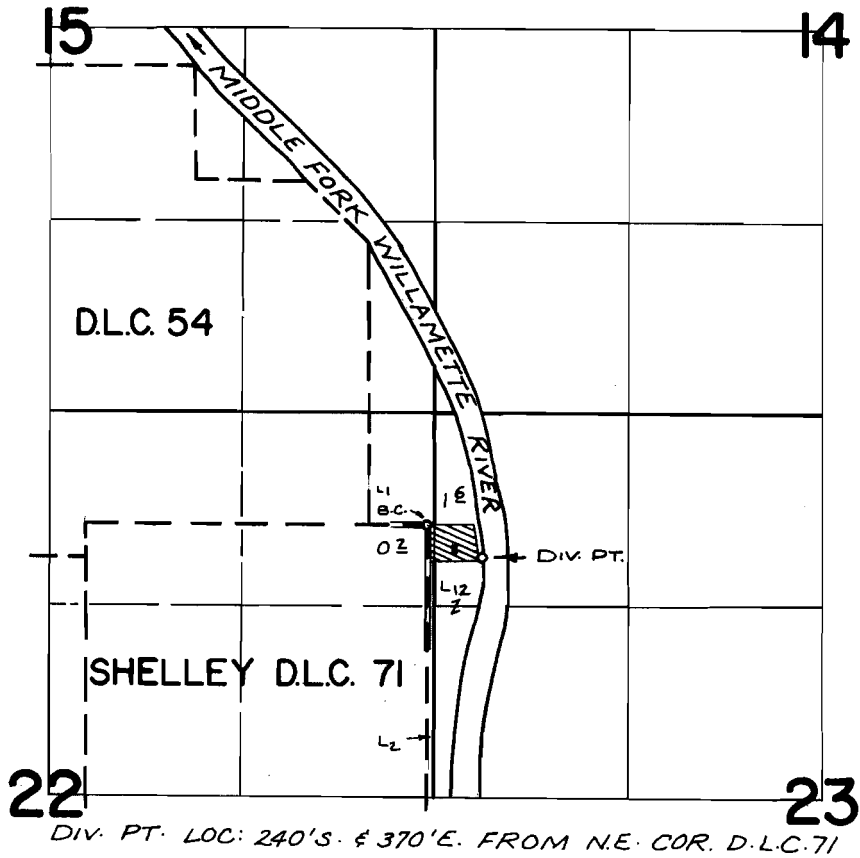

FINAL PROOF SURVEY UNDER

Application No. 44674 Permit No. 33446
IN NAME OF

ROGER SODERSTEDT

Surveyed MAY 6, 1974, by R. MUCKEN