


T.19&20S. R.11W. W.M.

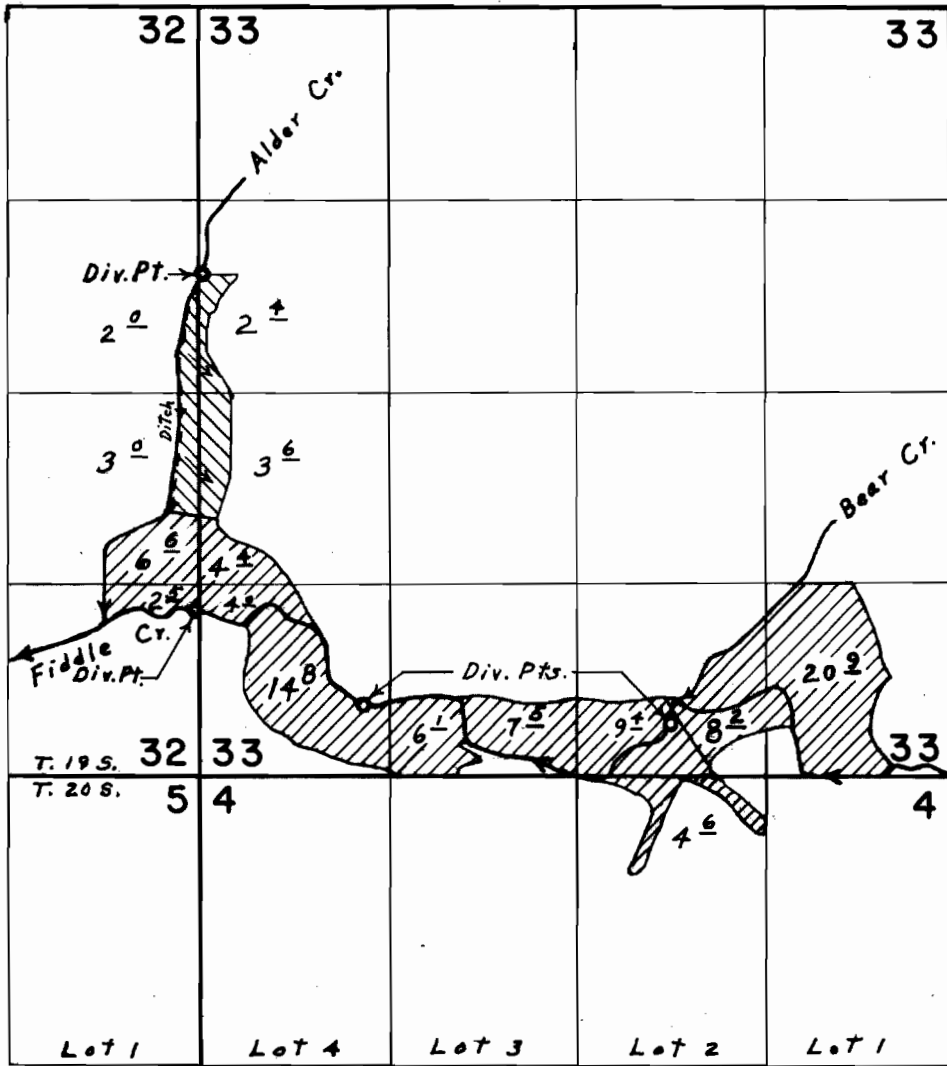

Div. Pts. located: Alder Cr., 3470' N. & 30' E.; Fiddle Cr., 1130' N. & 30' W., 360' N. & 3230' E., all from S. W. Cor. Sec. 33

FINAL PROOF SURVEY UNDER

Alder Cr. 
Fiddle Cr. 

Application No. 45044. Permit No. 33664.
IN NAME OF

LORN SMITH

Surveyed July 20, 1973, by L. E. Gould.