


T.11S., R.4W., W.M.

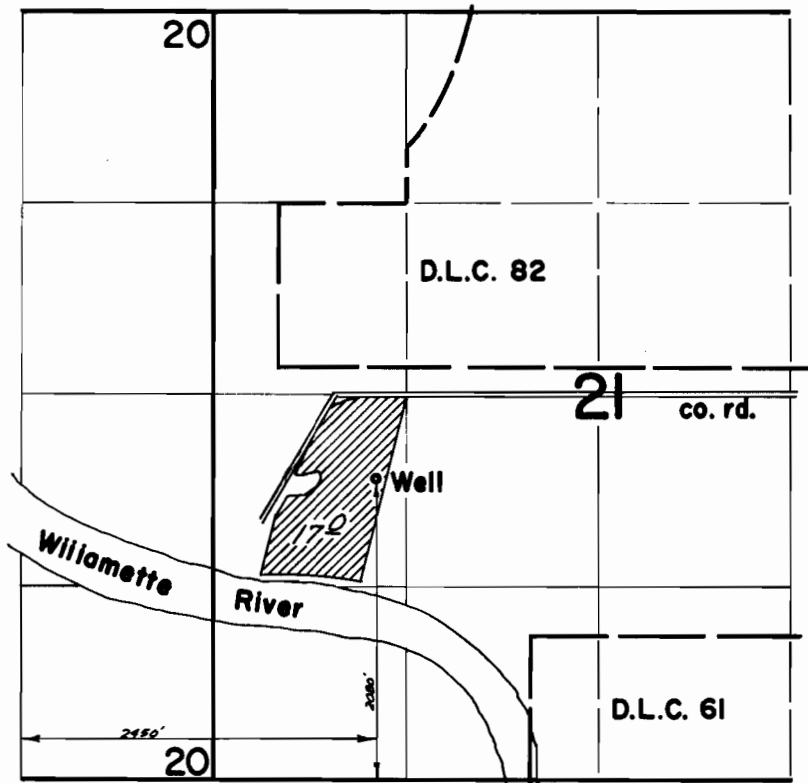

FINAL PROOF SURVEY
UNDER

Application No. G-4787 Permit No. G-4513
IN NAME OF

HOWARD ATKESON

Surveyed Oct. 1, 1973, by D. Norby