


T.I.O.S.R.I.E.W.M.

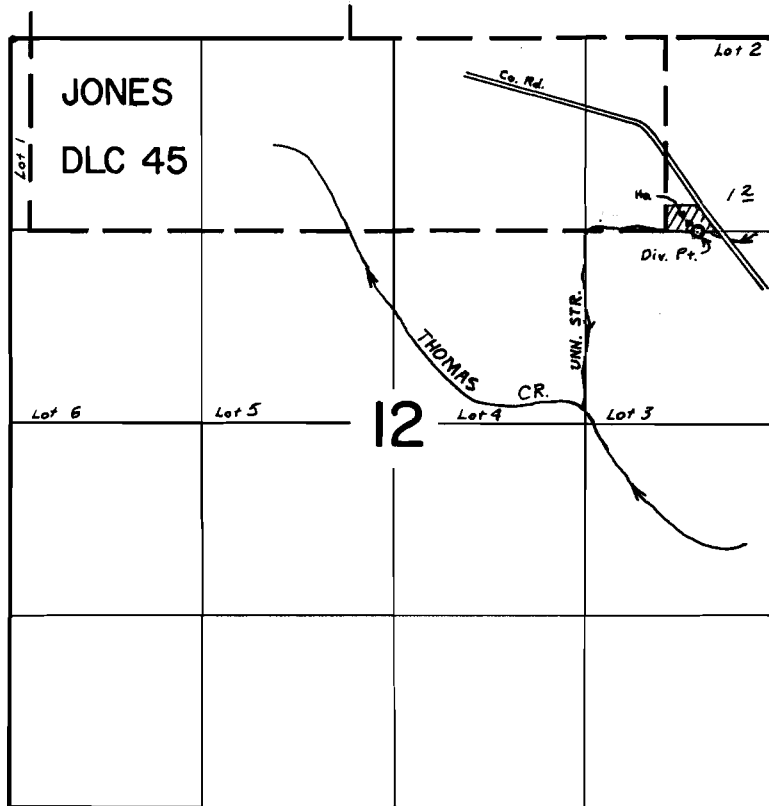

DIV. PT. LOCATED 10'S AND 210' E FROM SE COR. JONES DLC 45

FINAL PROOF SURVEY UNDER

Application No. 48548 Permit No. 36436
IN NAME OF

Sidney C. & Marlys F. Meek

Surveyed JULY 26 1973, by L.E. GOULD